



EAGLE VALLEY ENVIRON., INC. SURVEY

SCALE: 1" = 1000'

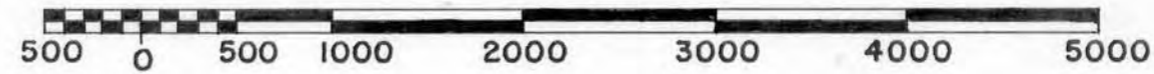

N

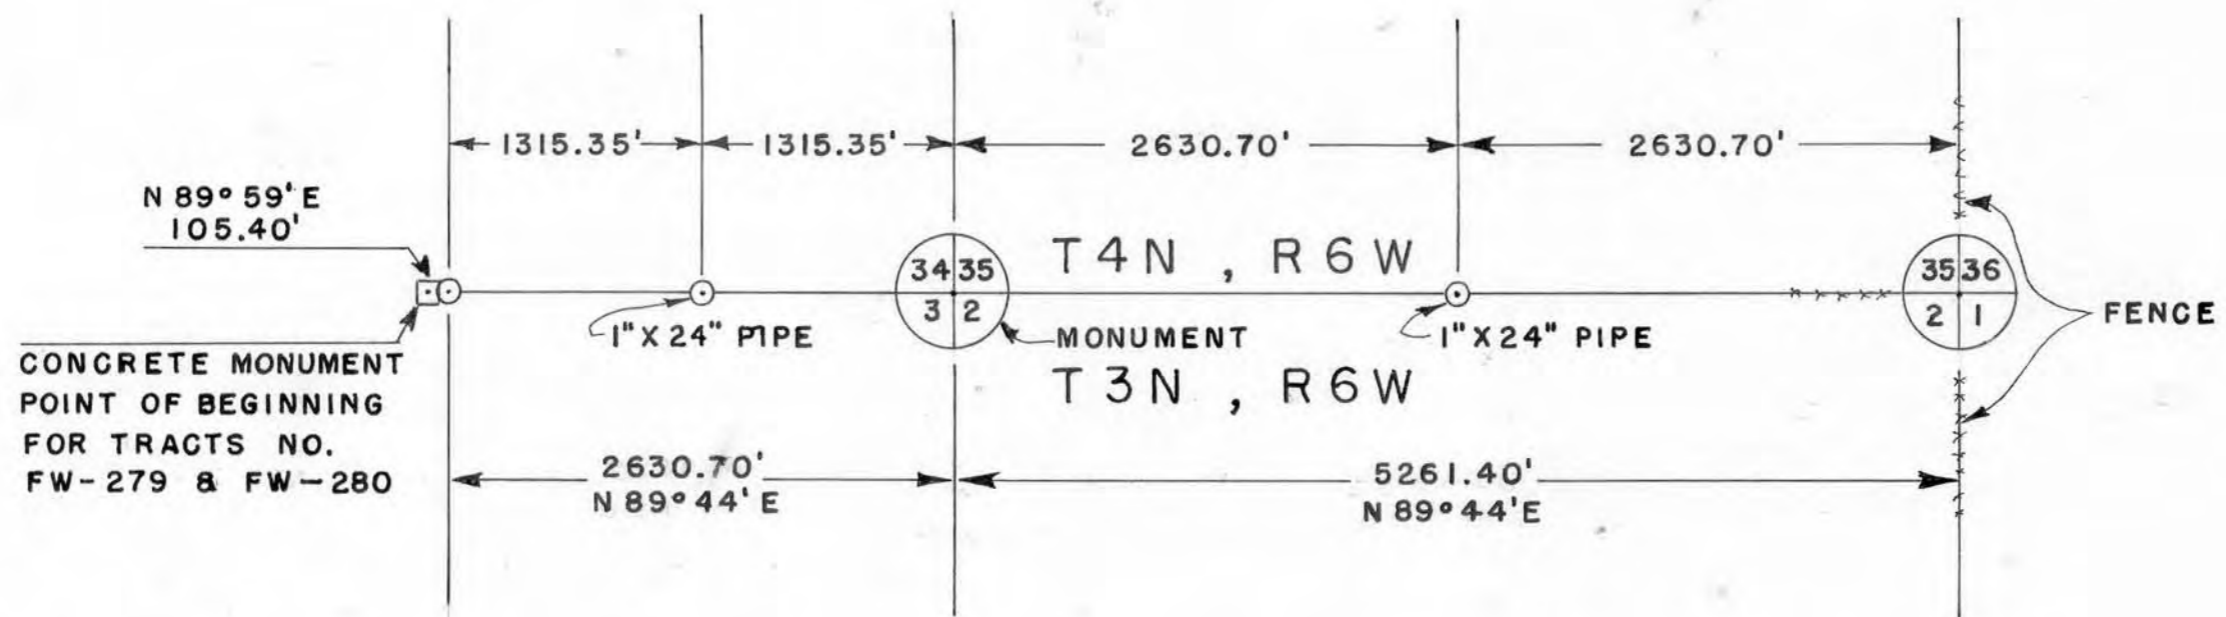

LINEAL ACCURACY
1/3000 OR GREATER



CORNERS SET BY PROPORTIONATE
MEASUREMENT AND EXISTING
PHYSICAL EVIDENCE.

David K. Krohn
DAVID K. KROHN
1/17/74 — 1/22/75

Homer D. Ralph, Jr.
HOMER D. RALPH, JR.
SURVEYOR FOR GRANT
COUNTY, WISCONSIN.



EAGLE VALLEY ENVIRON., INC. SURVEY

David K. Krohn
 DAVID K. KROHN
 1/17/74 - 1/28/74



Homer D. Ralph, Jr.
 HOMER D. RALPH, JR.
 SURVEYOR FOR GRANT
 COUNTY, WISCONSIN.

SCALE: 1" = 1000'

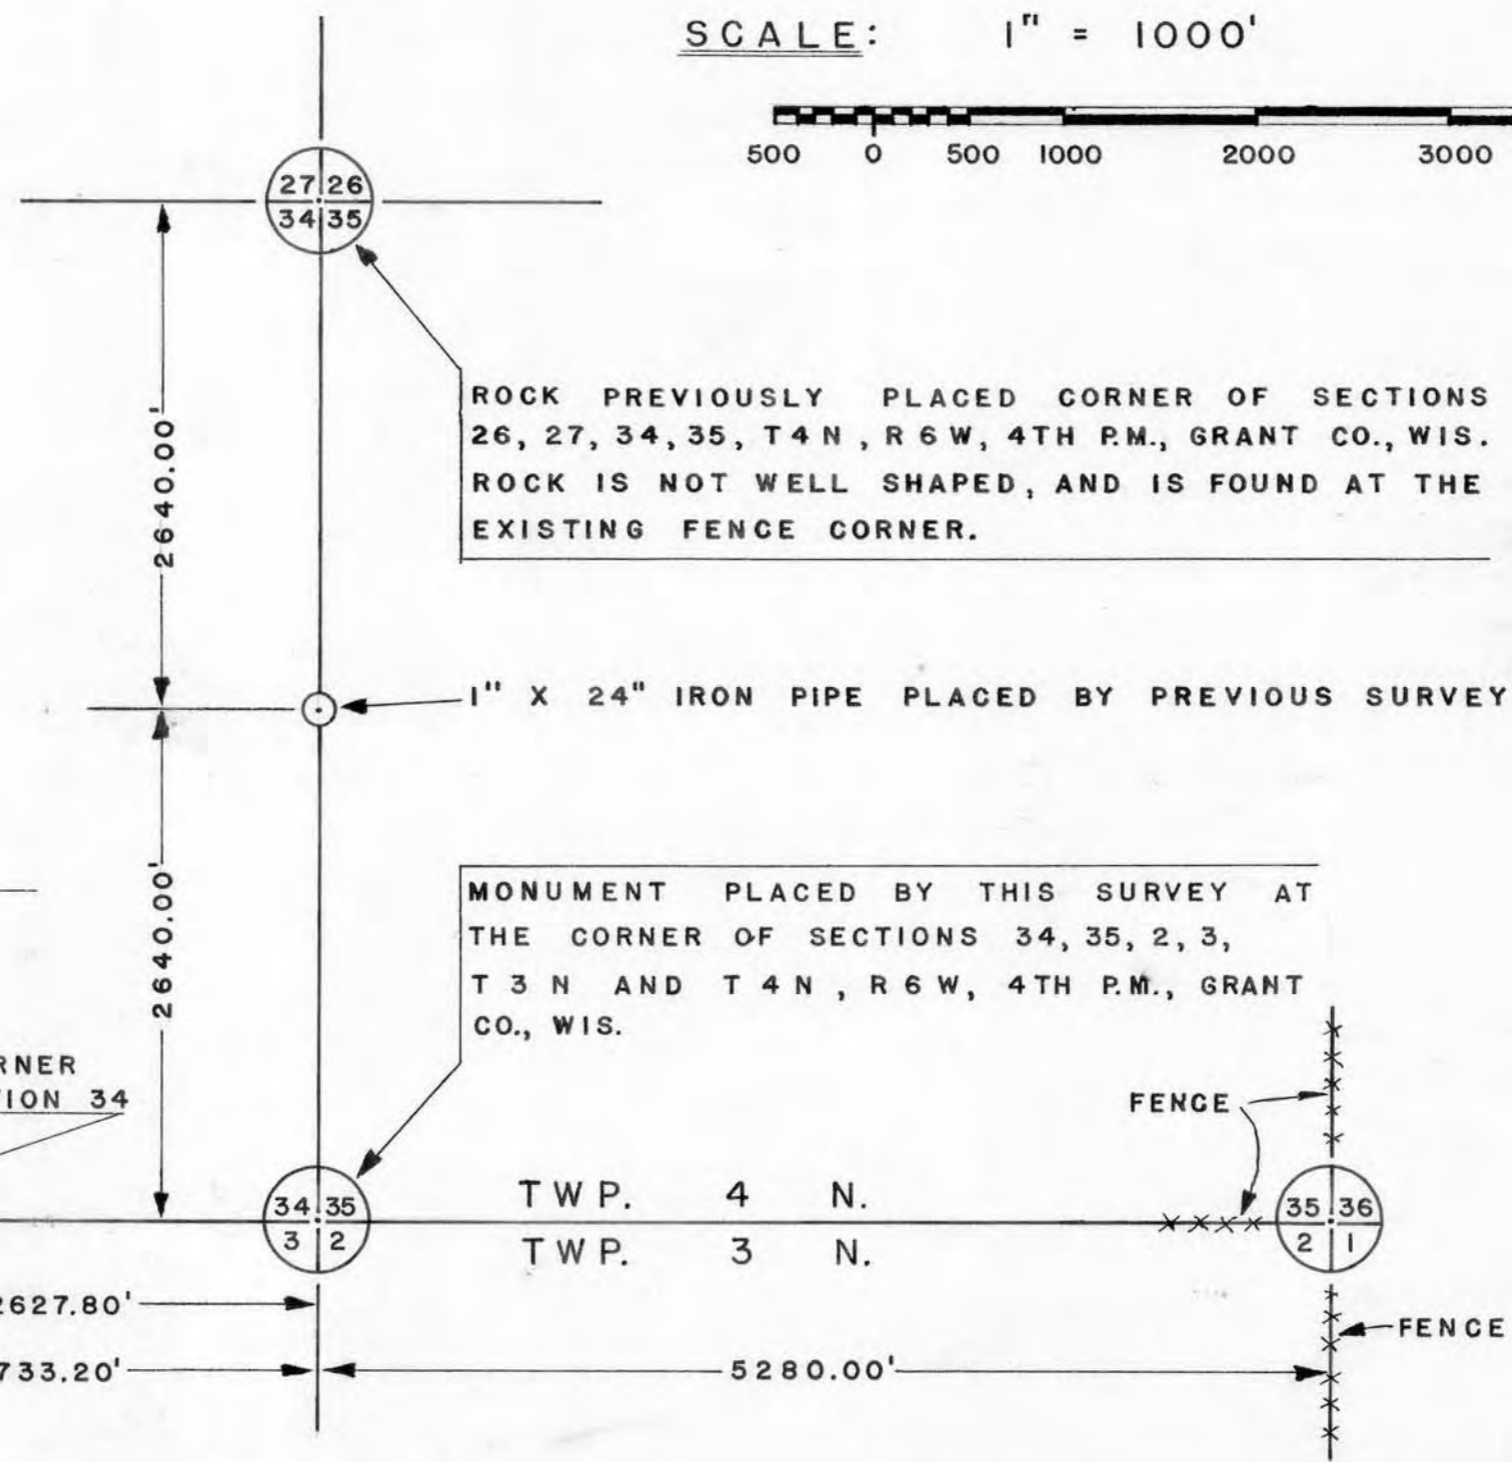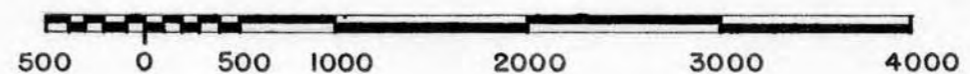

ROCK PREVIOUSLY PLACED CORNER OF SECTIONS 26, 27, 34, 35, T4N, R6W, 4TH P.M., GRANT CO., WIS. ROCK IS NOT WELL SHAPED, AND IS FOUND AT THE EXISTING FENCE CORNER.

MONUMENT PLACED BY THIS SURVEY AT THE CORNER OF SECTIONS 34, 35, 2, 3, T3N AND T4N, R6W, 4TH P.M., GRANT CO., WIS.

