

Bluff Street

PLAT OF SURVEY
OF

LOT ONE (1) AND THE NORTHERLY 1/2 OF THE VACATED ALLEY LYING SOUTH OF THE ABOVE DESCRIBED TRACT, ALL IN BLOCK 1 OF BRINDLEY'S ADDITION TO THE VILLAGE, NOW CITY, OF BOSCOBEL, GRANT COUNTY, WISCONSIN, ACCORDING TO THE RECORDED PLAT THEREOF.

STATE OF WISCONSIN)
COUNTY OF GRANT) SS

SURVEYOR'S CERTIFICATE

I, PAUL C. BRASHAW, A WISCONSIN REGISTERED LAND SURVEYOR, NO. S-1509, DO HEREBY CERTIFY THAT AT THE REQUEST OF BERNARD AND THERESA GARVEY, I HAVE BEEN FURNISHED THE ABOVE DESCRIBED LEGAL DESCRIPTION, AND THAT I HAVE MADE A RESURVEY OF THE ABOVE DESCRIBED TRACT BASED ON THIS LEGAL DESCRIPTION TO ESTABLISH THE BOUNDARY LINES AS SHOWN. THE RESULTS OF MY RESURVEY APPEAR ON THE ACCOMPANYING PLAT OF SURVEY AND THAT THE COURSES AND DISTANCES OF THE RESURVEY MAY VARY FROM THE RECORDED CALLS BASED ON THE EXISTENCE OF FOUND MONUMENTATION, OCCUPATION, OR OTHER CONTROLLING CALLS OR CONDITIONS THAT HAVE OCCURRED IN THE PERFORMANCE OF THIS RESURVEY. I FURTHER CERTIFY THAT I HAVE FOUND AND/OR SET THE SURVEY MONUMENTS ALL AS SHOWN AND THAT THERE ARE NO APPARENT ENCROACHMENTS EXCEPT AS SHOWN ON THE ACCOMPANYING PLAT.

SIGNED AND SEALED THIS 11TH DAY OF APRIL, 1983.

Paul C. Brashaw
PAUL C. BRASHAW
WISCONSIN REGISTERED LAND SURVEYOR
NO. S-1509




Legend


- 0.00' Measured Distance / Bearing
- 0.00' Platted Distance / Bearing
- Boundary of the Property Surveyed
- o 5/8" 30" Iron Rebar Set
- Iron Pipe Found
- x Chiseled "X" in Concrete Driveway



Scale : 1" = 30'

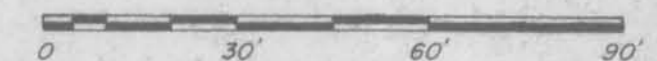

Surveyed for
Bernard and
Theresa Garvey

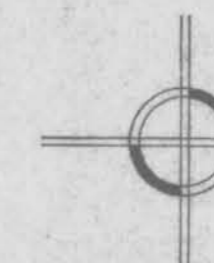

Snyder Brashaw Engineering

1601 S. Marquette Rd.
Prairie du Chien Wisconsin 53821
Telephone (608) 326-8448

