

BOSCOBEL BANK SURVEY

- LEGEND:**
- POWER TELE. LINE POLES
 - X 24" IRON PIPE, 113 LBS./LIN. FT
 - W.M. WATER MAIN
 - EXIST. WATER PIPE
 - EXIST. SEWER PIPE
 - BENCH MARK
 - ▲ ARROW ON TOP OF HYDRANT
 - ASSUMED ELEVATION: 100.00'
 - MANHOLE

Thomas S. Bainbridge
 THOMAS S. BAINBRIDGE
 4/16/68 - 4/20/68
 HOMER D. RALPH, JR.
 GRANT CO. SURVEYOR
 WIS. REG. NO. S-141


Homer D. Ralph, Jr.
 HOMER D. RALPH, JR.
 GRANT CO. SURVEYOR
 WIS. REG. NO. S-141

DESCRIPTION:
 THE NORTH 1/2 OF LOT 5, IN BLOCK 45 OF
 THE ORIGINAL PLAT OF THE VILLAGE (NOW CITY) OF
 BOSCOBEL, GRANT CO., WIS.

ELE. TOP 103.29'
 INV. 92.55'
 10" SAN. S.

WISCONSIN
 AVENUE

80'

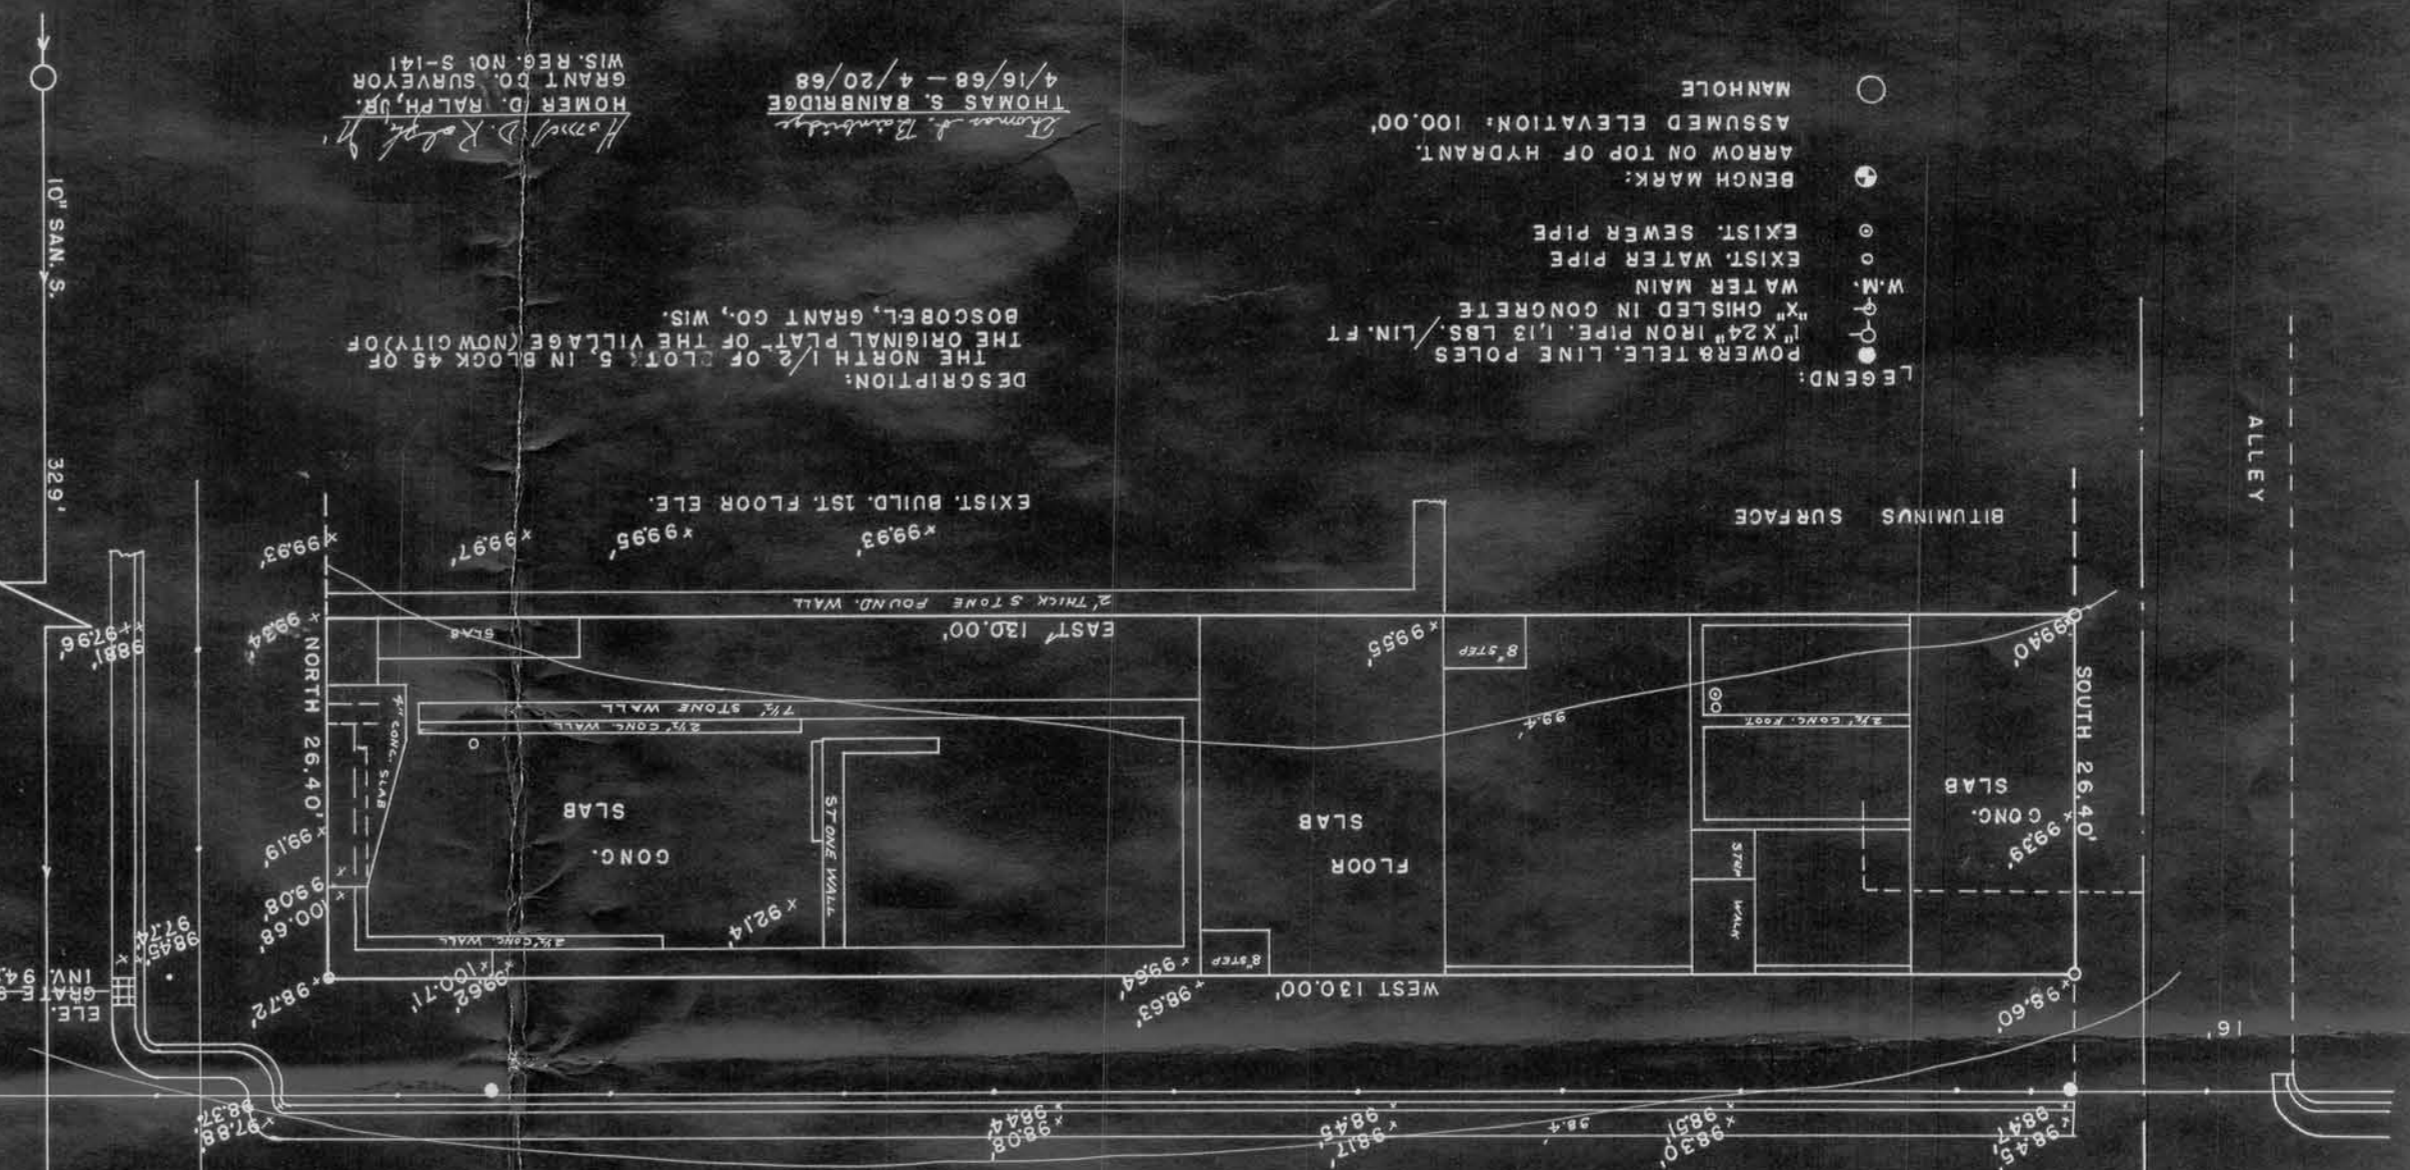

ALLEY

2" GAS MAIN

66'

OAK
 STREET

66'

80'

ELE. TOP 98.51'
 INV. 89.29'
 8" SAN. S.

ELE. TOP 97.88'
 INV. 88.60'
 8" W.M. 8"

B.M.

