


- Designates irons stakes placed by 1957 survey.
- Designates stakes placed by previous surveys.

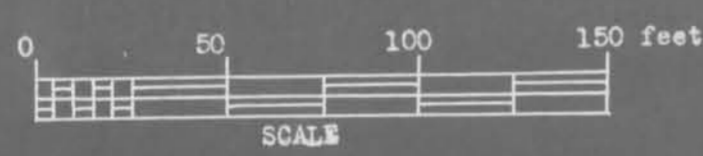

DESCRIPTION OF LANDS TO BE CONVEYED TO DON SPROUSE

Commencing at a point which is 475.65 feet East and 978.00 feet S 00° 32' E. ~~(XXXXXXXXXX)~~ of the Northwest corner of the East 1/2 of the N.E.1/4 of Section 10, T 4 N, R 3 W. of the 4th P.M. in Grant County, Wisconsin;

thence S 00° 32' E. 86.02 feet;

thence S 89° 28' W. 200.00 feet;

thence N 00° 32' W. 85.50 feet;

thence S 89° 48' W. 73.00 feet;

thence N 00° 42' E. 127.60 feet;

thence S 89° 29' E. 125.60 feet;

thence S 00° 13' E. 90.00 feet;

thence N 89° 09' E. 147.84 feet;

thence S 00° 32' E. 42.60 feet to the place of beginning.

The above described tract of land includes Lot 5 of Golf Heights Addition, except the South 5 feet thereof; Also part of Lots 1 and 2, Block 92 according to the Assessor's Plat Recorded in the Office of the Register of Deeds for Grant Co., Wis. in Vol. 1 of Plats, page 34, all lying and being in the City of Lancaster, Grant County, Wisconsin.

Homer D. Ralph, Jr.
 Homer D. Ralph, Jr., Surveyor
 for Grant Co., Wis.
 Wis. Reg. No. S-141