


PAUL SCHROEDER

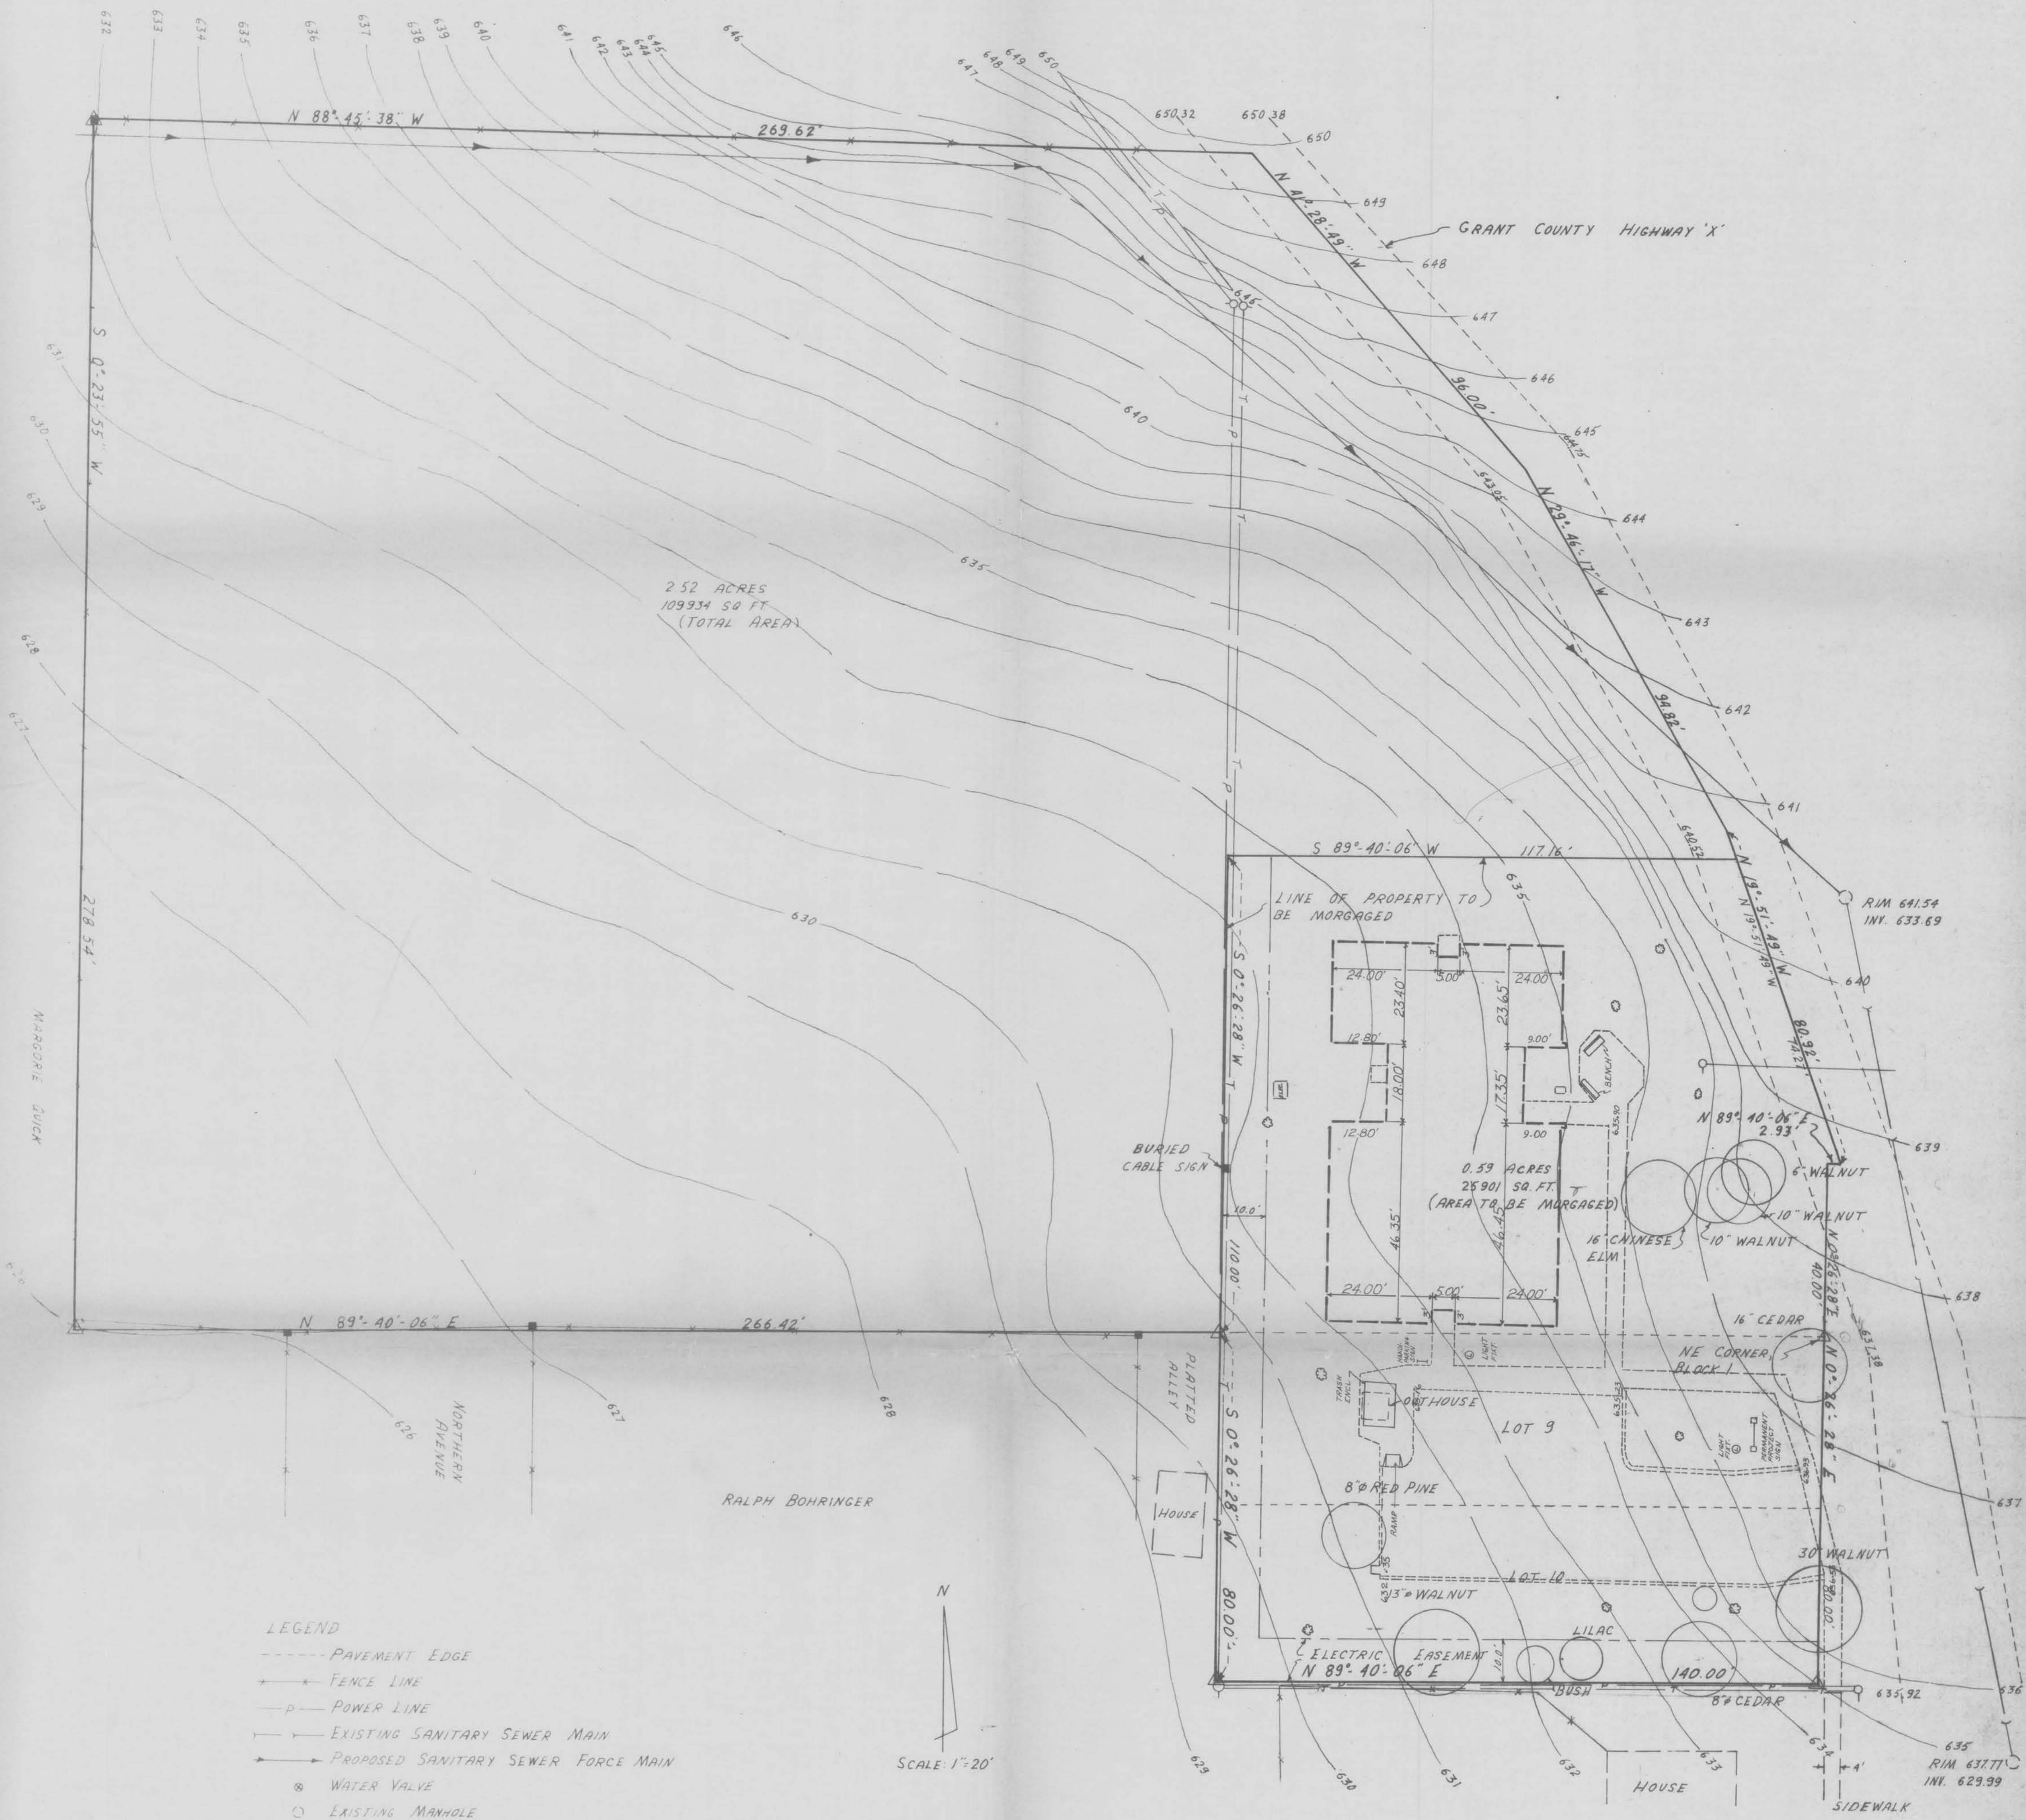

LEGEND

- PAVEMENT EDGE
- FENCE LINE
- POWER LINE
- EXISTING SANITARY SEWER MAIN
- PROPOSED SANITARY SEWER FORCE MAIN
- ⊗ WATER VALVE
- EXISTING MANHOLE
- POWER LINE
- TELEPHONE CABLE
- △ 7/4 DIAMETER x 24" REINFORCING BAR PLACED MIN WT 150 LBS./LIN. FT.
- 12" SQUARE WOOD POST
- WATER MAIN

NOTES


BENCH MARK NORTH RIM OF MANHOLE - ELEV 641.54
 NO NATURAL GAS AVAILABLE
 FOR ADDITIONAL INFORMATION ON BURIED CABLE CONTACT PEOPLE'S TELEPHONE CO. MT HOPE WISCONSIN

LOCATION OF UNDERGROUND UTILITIES COULD NOT BE DETERMINED.

I CERTIFY THAT ON DECEMBER 21, 1978 I MEASURED THE IMPROVEMENTS SHOWN HEREON AND THAT THE PLAT SHOWN IS AN ACCURATE AND TRUE REPRESENTATION OF SAID IMPROVEMENTS TO THE BEST OF MY KNOWLEDGE AND BELIEF.

DATED THIS 5TH DAY OF JANUARY, 1979

Kenneth A. Kerst, Jr.
 KENNETH A. KERST, JR.
 REGISTERED LAND SURVEYOR S-1385

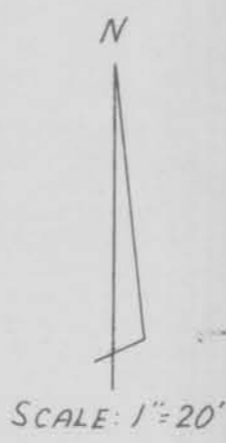

DESCRIPTION FOR: Hornz Partners April 21, 1977

A SURVEY OF A PARCEL OF LAND DESCRIBED AS FOLLOWS:

Beginning at the northeast corner of Block 1 of the original town of the Village of Bagley, T. 5 N., R. 6 W., Grant County, Wisconsin; thence N 0°-26'-28" E, 40.00 feet; thence N 89°-40'-06" E, 25.93 feet to a point in the centerline of Grant County Highway 'X'; thence N 19°-51'-49" W, 80.92 feet to a point in said centerline; thence N 29°-46'-17" W, 94.82 feet to a point in said centerline; thence N 41°-28'-49" W, 96.08 feet to a point in said centerline; thence N 88°-43'-38" N, 289.62 feet to a 3/4 inch diameter reinforcing bar; thence S 0°-23'-35" W, 278.54 feet to a 3/4 inch diameter reinforcing bar; thence N 39°-40'-06" E, 266.42 feet to a 3/4 inch diameter reinforcing bar at the northwest corner of Lot 9 of said Block 1; thence S 0°-26'-28" W, 80.00 feet to a 3/4 inch diameter reinforcing bar at the southeast corner of Lot 10 of Block 1; thence N 89°-40'-06" E, 140.00 feet to a 3/4 inch diameter reinforcing bar at the point of beginning; thence N 0°-26'-28" E, 80.00 feet to the point of beginning.

The above described parcel of land being located partly in Lots 9 and 10 of Block 1, the original town of the Village of Bagley, and partly in the northeast quarter (NE 1/4) of the southeast quarter (SE 1/4) of Section 17, all in T. 5 N., R. 6 W., Grant County, Wisconsin and containing 2.52 acres and being subject to conveyance for roadway purposes.

I certify that I have surveyed the above described parcel of land and that the plat is an accurate survey and a true representation thereof and the topographic features shown thereon and correctly shows the exterior boundary lines of said parcel and said topographic features and the belief measurements thereon to the best of my knowledge and belief.

Dated this 3rd day of May, 1977
 Richard Center, Wisconsin
 Herman J. Hovelstrud
 Registered Land Surveyor S-7149