


LOT 1, BLOCK 55 OF THE ASSESSMENT PLAT
 PLATTEVILLE, WIS.

BEGIN 322.84' SOUTH $\frac{1}{4}$ 155.55'
 EAST OF THE N. W. COR. OF THE
 S.W. $\frac{1}{4}$ OF SEC. 10, T3N, R1W OF
 THE 4TH P.M.



SCALE: 1" = 100'

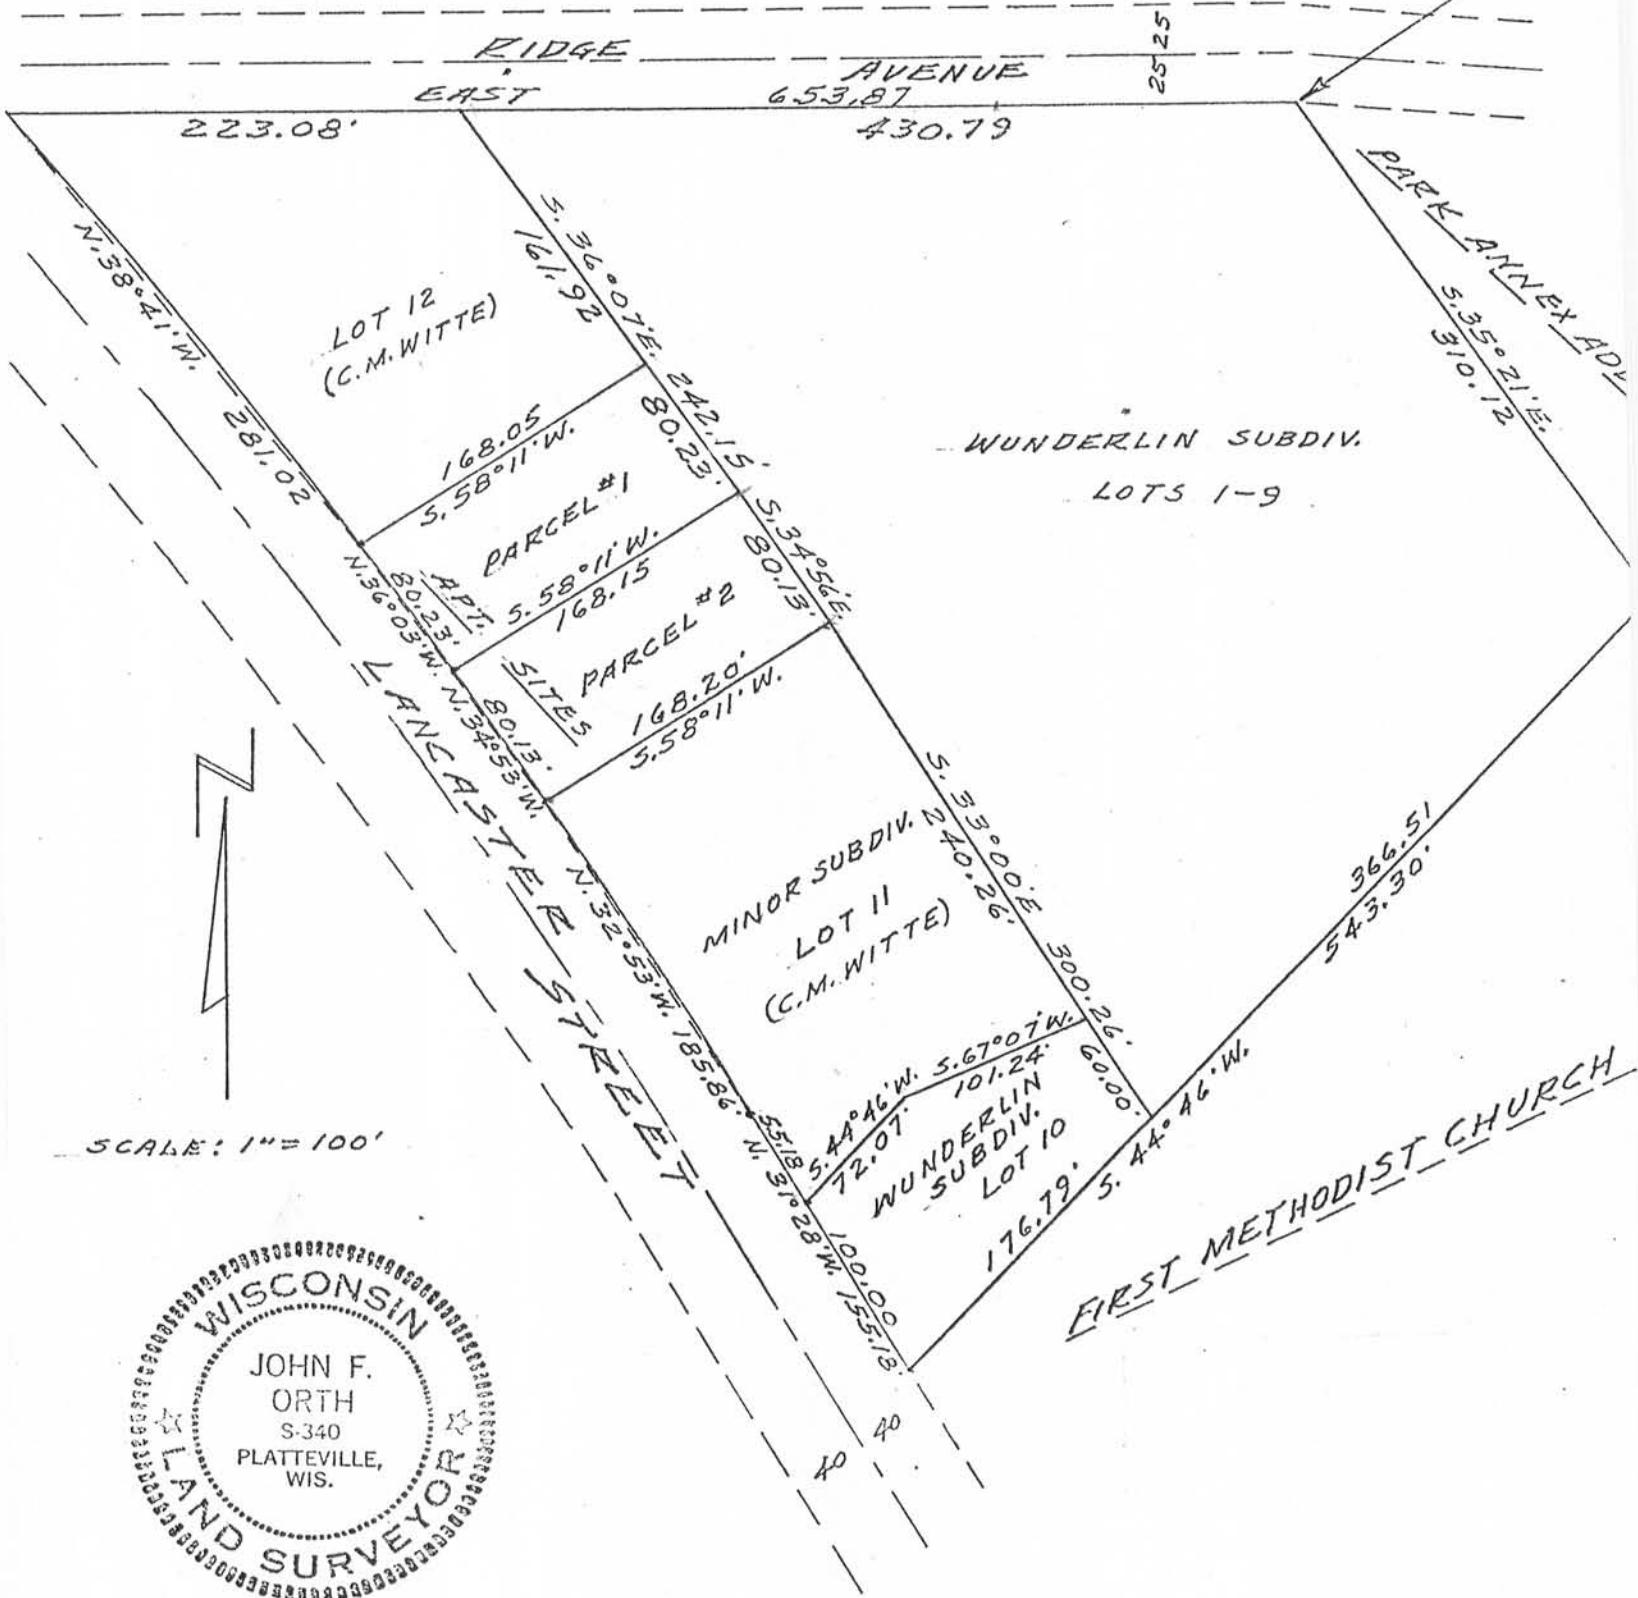