

S 73° E  
253 L.

ROAD OUT

W

JOHN CUTLER

S 73 1/2° E 75'

S 73° E

253 L.  
60'

N 20° E 154'

S 20° W 154'

S 20° W 154'

GARAGE

THOMAS LOT

GIVEN AS N 16 1/2° E IN # 23 ABSTRACT (QUIT CLAIM DEED SWELIKER TO THOMAS)  
ALL OTHER PLACES AS N 20° E. ??  
SAME IN DEED IN 16 1/2° E.

MAIN ST. SUB  
(CAS ST.)

GARAGE BLDG  
57 ON MAIN

SE. CORNER LOT 4 CARLS ADD  
ON MAIN ST.  
Also s. to corner

NOTE  
WHY DID HARRIS  
BUY THE 14'??  
WAS HE SHORT OF  
ROOF??

NO DIST. GIVEN  
IN # 23 ABSTRACT  
ALL OTHER PLACES GIVEN  
AS 15'. BEARINGS  
EXCEPT EAST & WESTERLY

WOOD BUILDING  
34' ON MAIN  
TO WIDE  
AT BACK

SMELIKER LOT



WORK DONE  
DEC. 4<sup>th</sup> 1958

N.W. CORNER BLOCK C ROUNDTREES  
E. ADD


WATER ST

88'

N 17° E  
18'

S 73° E  
253 L.

ROAD OUT

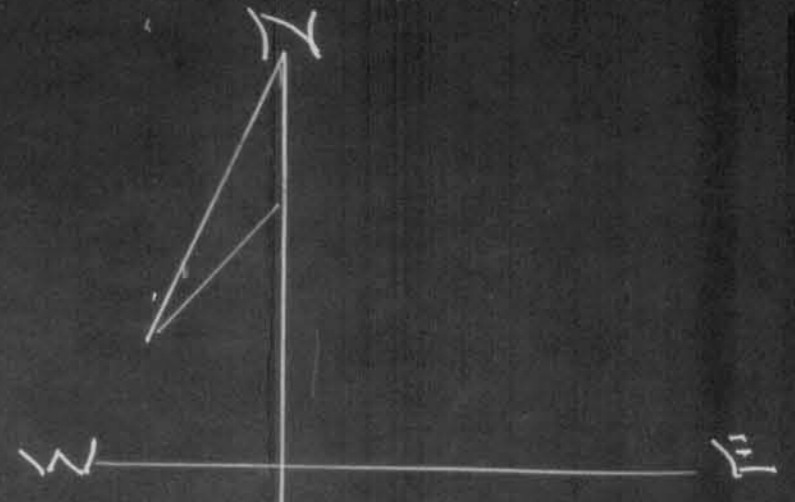

5056' *Cut down*

5.73 1/2° E 75'

N.W. CORNER  
LOT 4  
CARLS ADD

S 73° E

25 3/4 L.  
166' L.

5'0"

14'  
18'

61'

40'  
20'

N. LINE  
MAIN ST.  
(103 1/2' GAS ST.)

GARAGE

N 20° E 154'

S 20° W  
154'

THOMAS'S  
LOT

S 20° W 154'

GIVEN AS N 16 1/2° E IN # 23 ABSTRACT  
ALL OTHER PLACES AS N 20° E.  
SAME IN DEED N 16 1/2° E.

GARAGE OLD  
57 ON MAIN

SE. CORNER LOT 4 CARLS ADD  
ON MAIN ST.  
Also S. 2. Corner Stamp

NO DIST. GIVEN  
IN # 23 ABSTRACT  
ALOTHER PLACES GIVEN  
AS 75'. PLACES GIVEN  
NO BEARINGS  
EXCEPT EAST BY WESTERLY

SMELIKER  
LOT

S 20° E