

DESCRIPTION:

PART OF THE SOUTHEAST QUARTER OF SECTION 3, T 4 N, R 3 W, OF THE 4TH P.M., GRANT COUNTY, WISCONSIN, DESCRIBED AS FOLLOWS TO-WIT: BEGIN AT THE SOUTHWEST CORNER OF BLOCK 40 OF THE VILLAGE (NOW CITY) OF LANCASTER; THENCE SOUTH 563.30 FEET TO THE SOUTH LINE OF SECTION 3; THENCE SOUTH 89° 45' EAST 313.50 FEET ALONG SAID SECTION LINE; THENCE NORTH 563.30 FEET; THENCE NORTH 89° 45' WEST 313.50 FEET TO THE POINT OF BEGINNING. CONTAINING 4.05 ACRES MORE OR LESS.

LEGEND:

- 1" X 24" IRON PIPE PLACED BY THIS SURVEY.
- CHISEL MARK MADE BY THIS SURVEY
- ⊙ TREE WITH DIAMETER
- ⊙ MANHOLE
- I.E. INVERT ELEVATION
- +50.0 ELEVATION SHOT (1050.0)
- ⊕ CURB STOP
- ⊕ ELECTRICAL POLE
- ⊕ ELECTRICAL, PHONE, CABLE T.V. POLE
- ELECTRICAL LINE
- GAS LINE
- WATER MAIN
- SANITARY SEWER
- STORM SEWER
- CURB AND GUTTER
- GATCH BASIN
- FENCE
- CONTOUR LINE (ELEV. 1050)
- PROPERTY LINE
- RIGHT-OF-WAY
- CENTERLINE

CERTIFICATE:

STATE OF WISCONSIN) S.S.
 COUNTY OF GRANT)
 I, HOMER D. RALPH, JR. HEREBY CERTIFY THAT I HAVE SURVEYED OR DIRECTED THE SURVEYING OF BLOCK 55, OF THE ASSESSMENT PLAT OF THE CITY OF LANCASTER, GRANT COUNTY, WISCONSIN, AND THAT THIS MAP IS A TRUE AND CORRECT REPRESENTATION OF SUCH SURVEY.


DATE: 5/20/74

Homer D. Ralph, Jr.
 HOMER D. RALPH, JR.
 REGISTERED LAND SURVEYOR



ELECTRIC LINE
 12,000 VOLT
 3 PHASE

SCALE: 1" = 20'

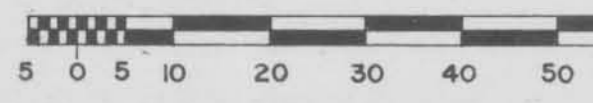

DRAWING
 DATE
 DRAWN BY
 REVISIONS

PROJECT SUNRISE VALLEY APTS., INC.

