

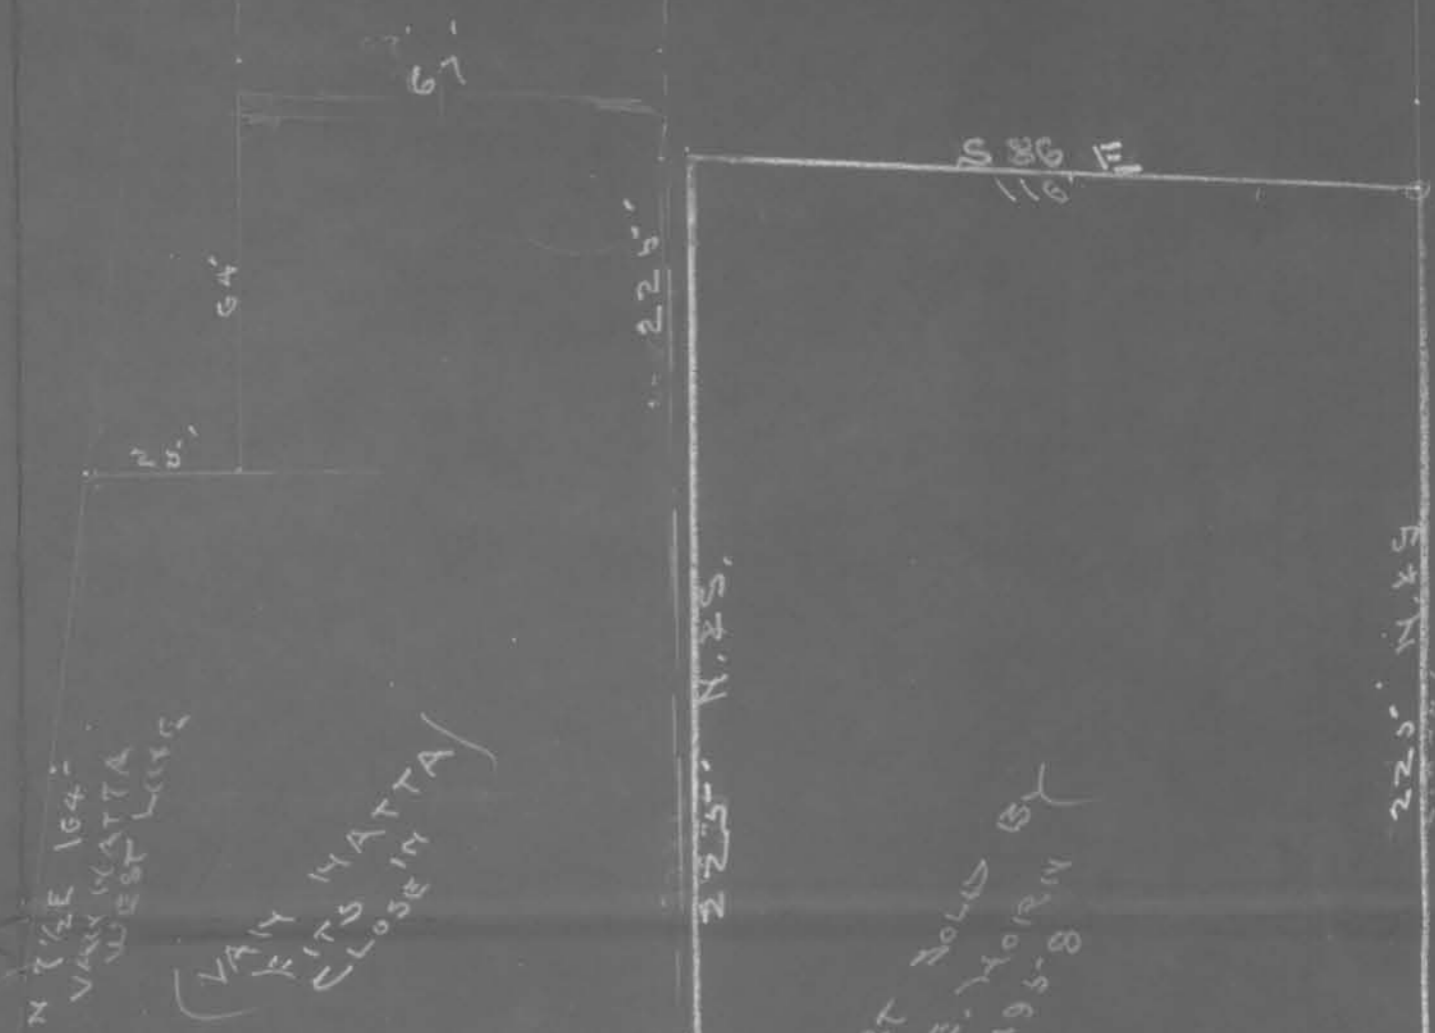


ion of the  
the C1

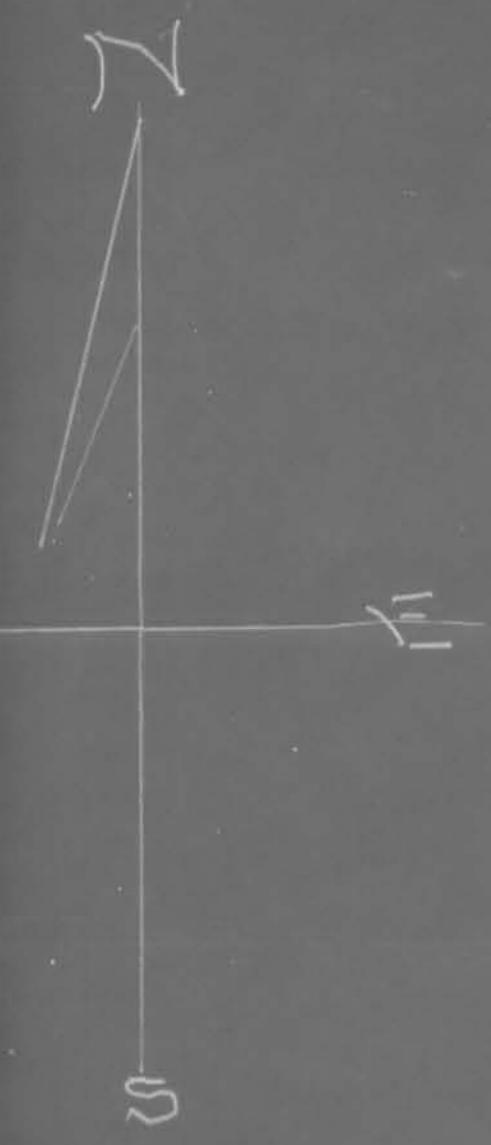

S.W. Corner  
V. HATTA  
LAND  
(GRANT ST.)

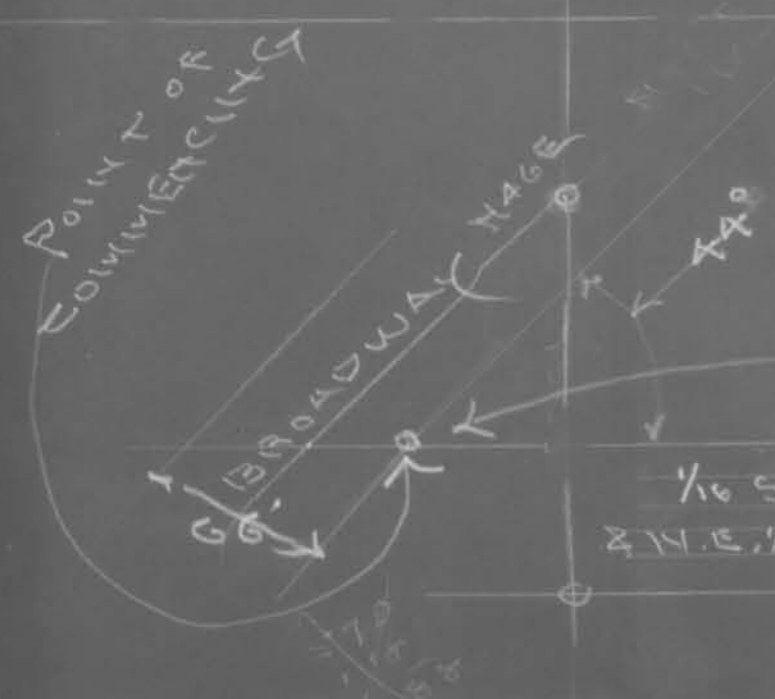

1/4 SECT, CORNER, BETWEEN N.W. 1/4, SECT, 14  
& N.E. 1/4 SECT, 15, T. 3. N. R. 1. W., 4th P. M.

STAKE 1/4  
POINT BEGINNING  
OF PART SOLD  
South line of Grant St  
above by E. C. Clark  
Oct. 1958 Peabody Wis