
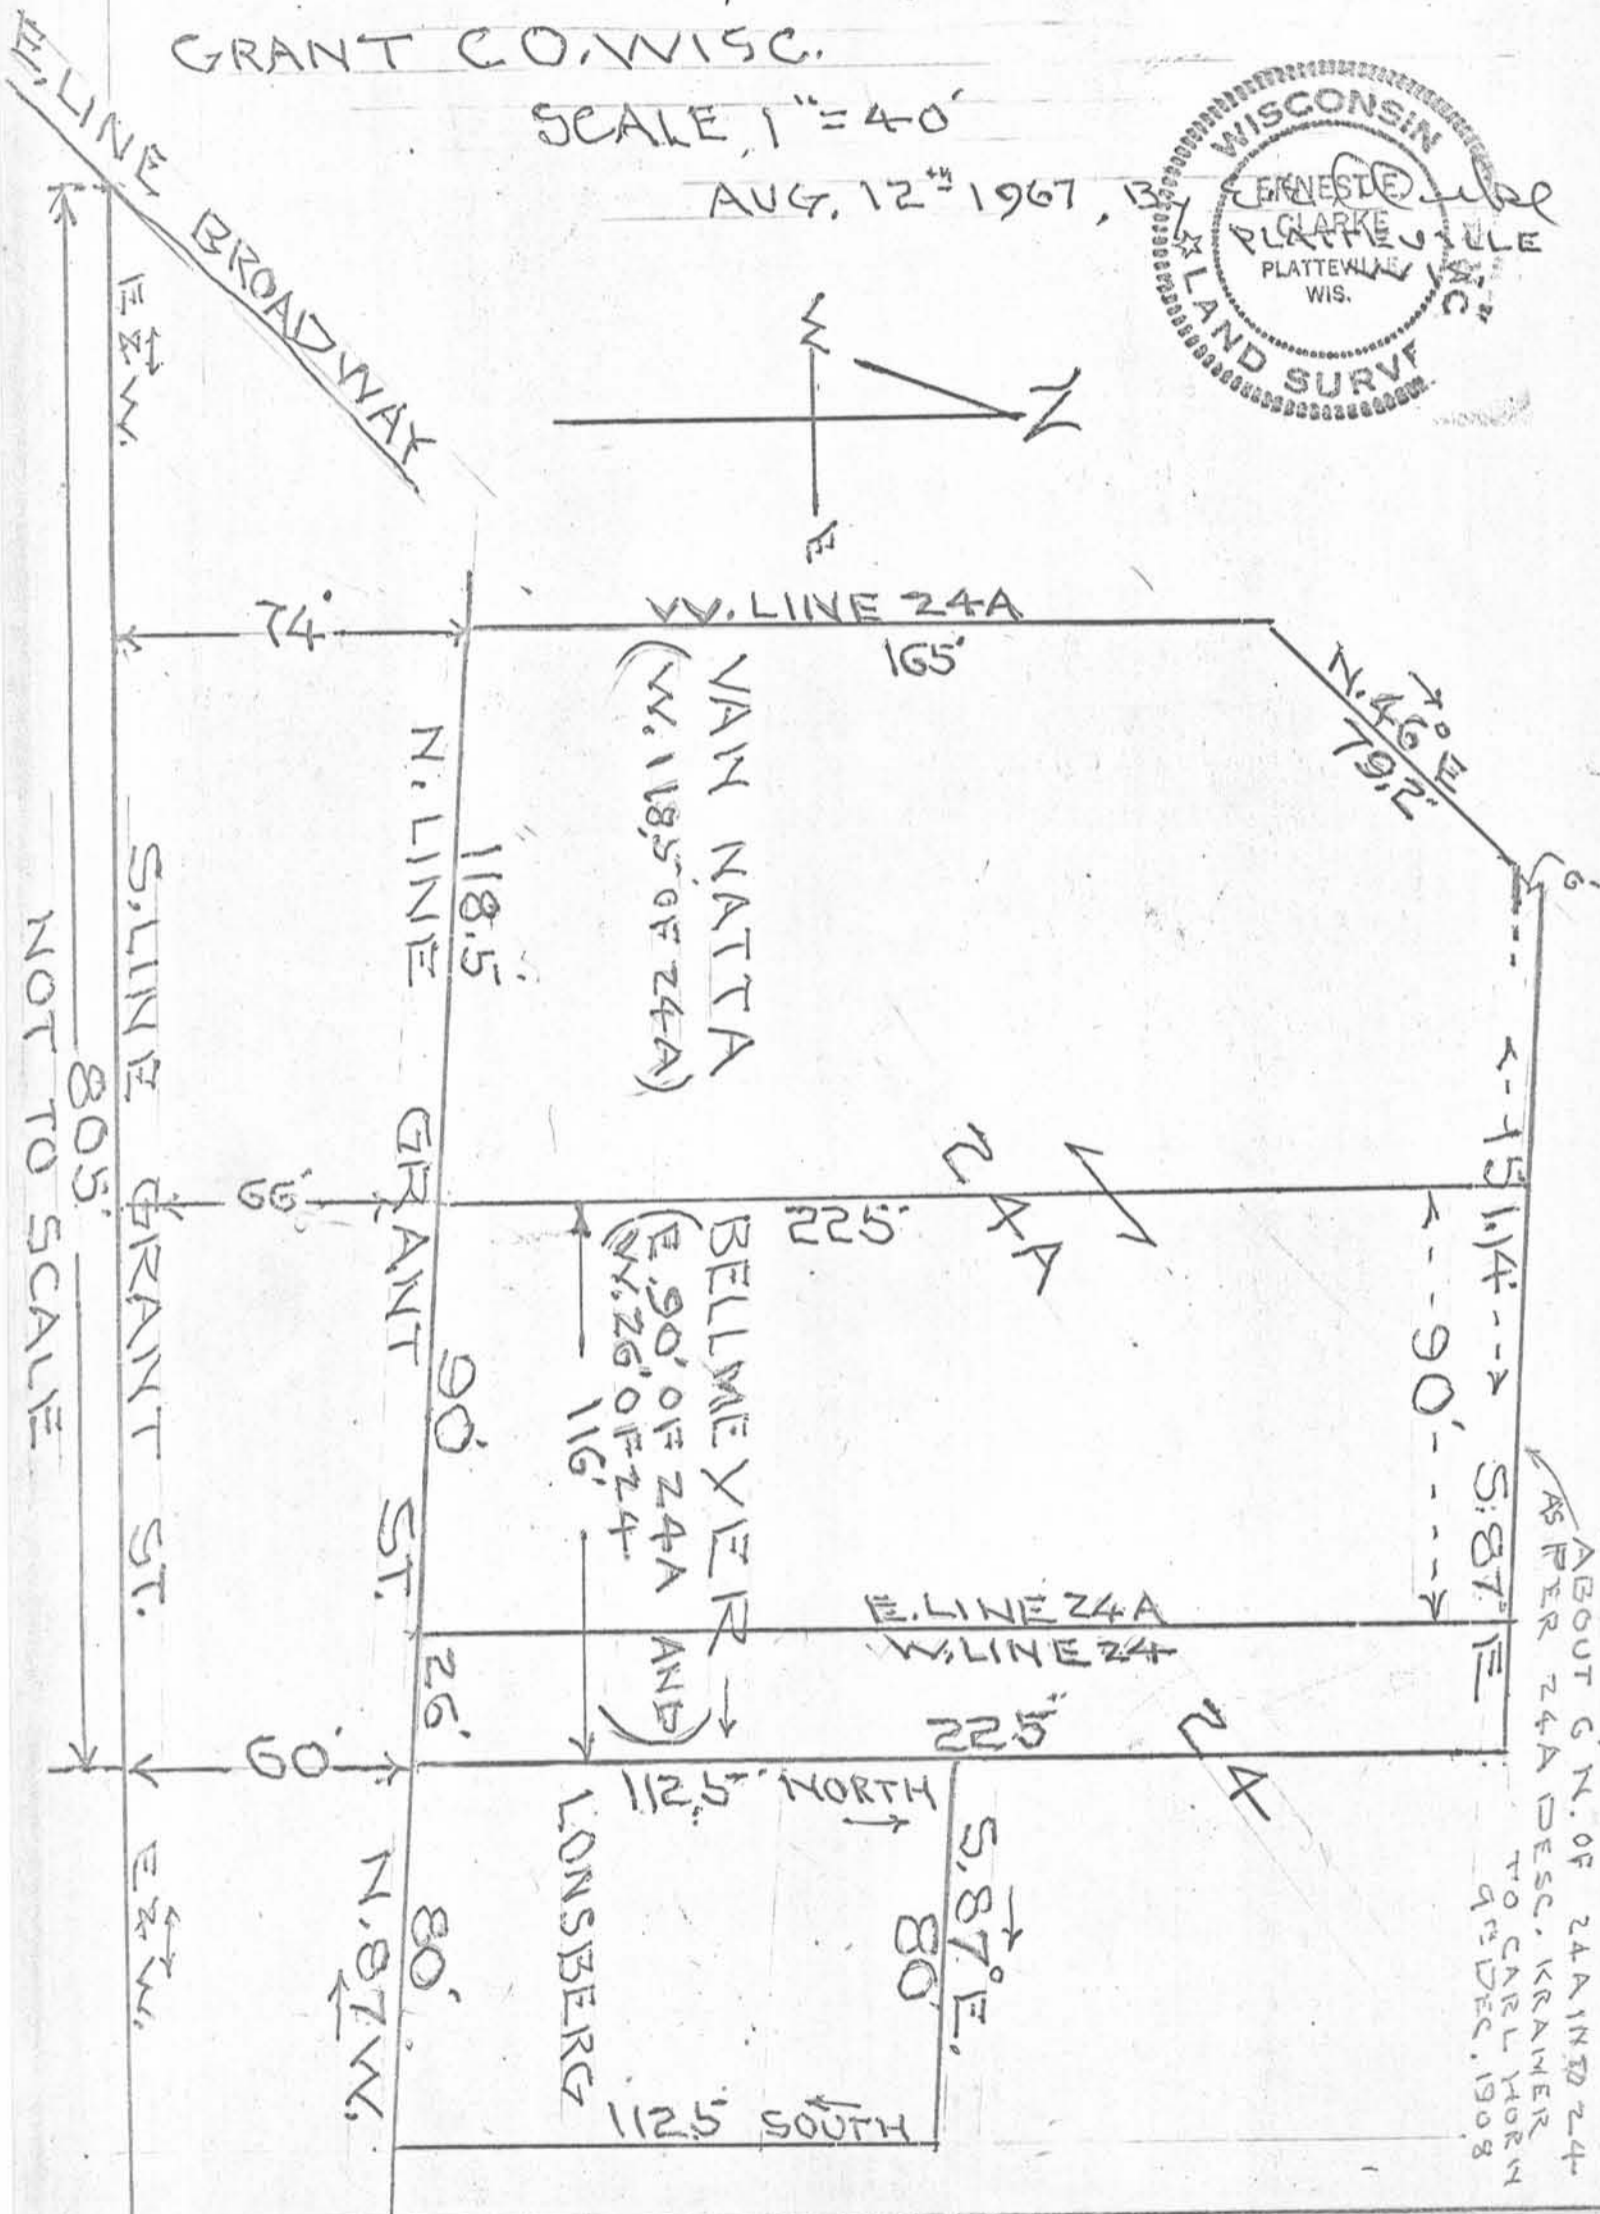


BELLMeyer & LONsBERG LAND
 IN LOTS 24A & 24, ROUNTREE'S
 N.E. ADDITION, CITY OF PLATTEVILLE
 GRANT CO., WISC.

SCALE, 1" = 40'

AUG. 12th 1967, B

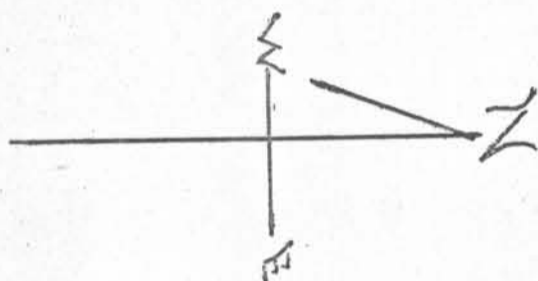

NOT TO SCALE

ABOUT S. N. OF 24A IN RD 24
 AS PER 24A DESC. KRAIMER
 TO CARL HORN
 9th DEC. 1908