

JAMES J. BURNS
PLAT OF RESURVEY

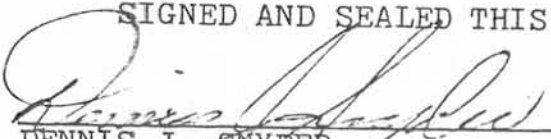
LOTS NUMBERED 216, 218, AND 220 ALL IN THE TOWN OF GLEN HAVEN,
GRANT COUNTY, WISCONSIN.

STATE OF WISCONSIN)
COUNTY OF GRANT) SS

SURVEYOR'S CERTIFICATE

I, DENNIS J. SNYDER, A WISCONSIN REGISTERED LAND SURVEYOR, NO. S-1832, DO HEREBY CERTIFY THAT AT THE REQUEST OF MR. JAMES J. BURNS, I HAVE MADE A RESURVEY OF THE ABOVE DESCRIBED LEGAL DESCRIPTION AND THAT I HAVE FOUND AND/OR SET THE SURVEY MONUMENTS, ALL AS SHOWN AND THAT THERE ARE NO APPARENT ENCROACHMENTS, EXCEPT AS SHOWN ON THE ACCOMPANYING PLAT. IT SHOULD BE NOTED THAT IN THE PERFORMANCE OF THE RESURVEY, THE COURSES AND DISTANCE OF THE RESURVEY MAY VARY FROM THE RECORDED CALLS BASED ON THE EXISTANCE OF FOUND MONUMENTATION, OCCUPATION OR OTHER CONTROLLING CALLS OR CONDITIONS THAT HAVE OCCURED IN THE COURSE OF THIS SURVEY, AND IN ACCORDANCE WITH THE INFORMATION FURNISHED TO THE BEST OF MY KNOWLEDGE AND BELIEF.

SIGNED AND SEALED THIS 27TH DAY OF JUNE, 1985.

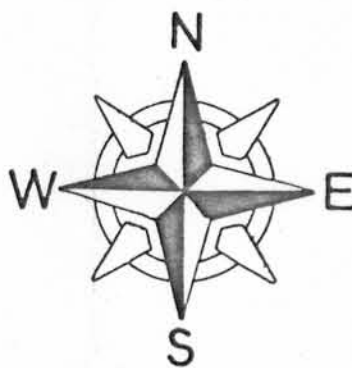

DENNIS J. SNYDER
WISCONSIN REGISTERED LAND SURVEYOR
NO. S-1832

NOTE:
FOR THE PURPOSES OF THIS SURVEY THE EASTERLY LINE OF FOURTH STREET IS ASSUMED TO BEAR N.14°15'00"E.

LEGEND

0.00' MEASURED DISTANCE/BEARING
(0.00') PLATTED DISTANCE/BEARING
BOUNDARY OF THE PROPERTY SURVEYED
5/8" x 30" IRON REBAR SET
WEIGHING 1.13 LBS./LIN. FT.
1" IRON PIPE FOUND

Surveyed for
Mr. James J. Burns



SNYDER ENGINEERING ASSOCIATES
120 S. BEAUMONT ROAD
P.O. BOX 235
U.S. POST OFFICE BUILDING-LOWER LEVEL
PRAIRIE DU CHIEN, WISCONSIN 53821
TELEPHONE (608) 326-8448