


PLAT OF SURVEY

PREPARED BY - TERRAMETRICS
ENGINEERING LTD.
208 PHILLIPS BLVD.
SAUK CITY, WISCONSIN

BEING LOTS 2 AND 3 OF BLOCK 1, BAHL'S ADDITION
TO THE CITY OF FENNIMORE, GRANT COUNTY, WISCONSIN

PREPARED FOR - LLOYD MATTIX
4928 FOXFIRE TR.
MIDDLETON, WISCONSIN

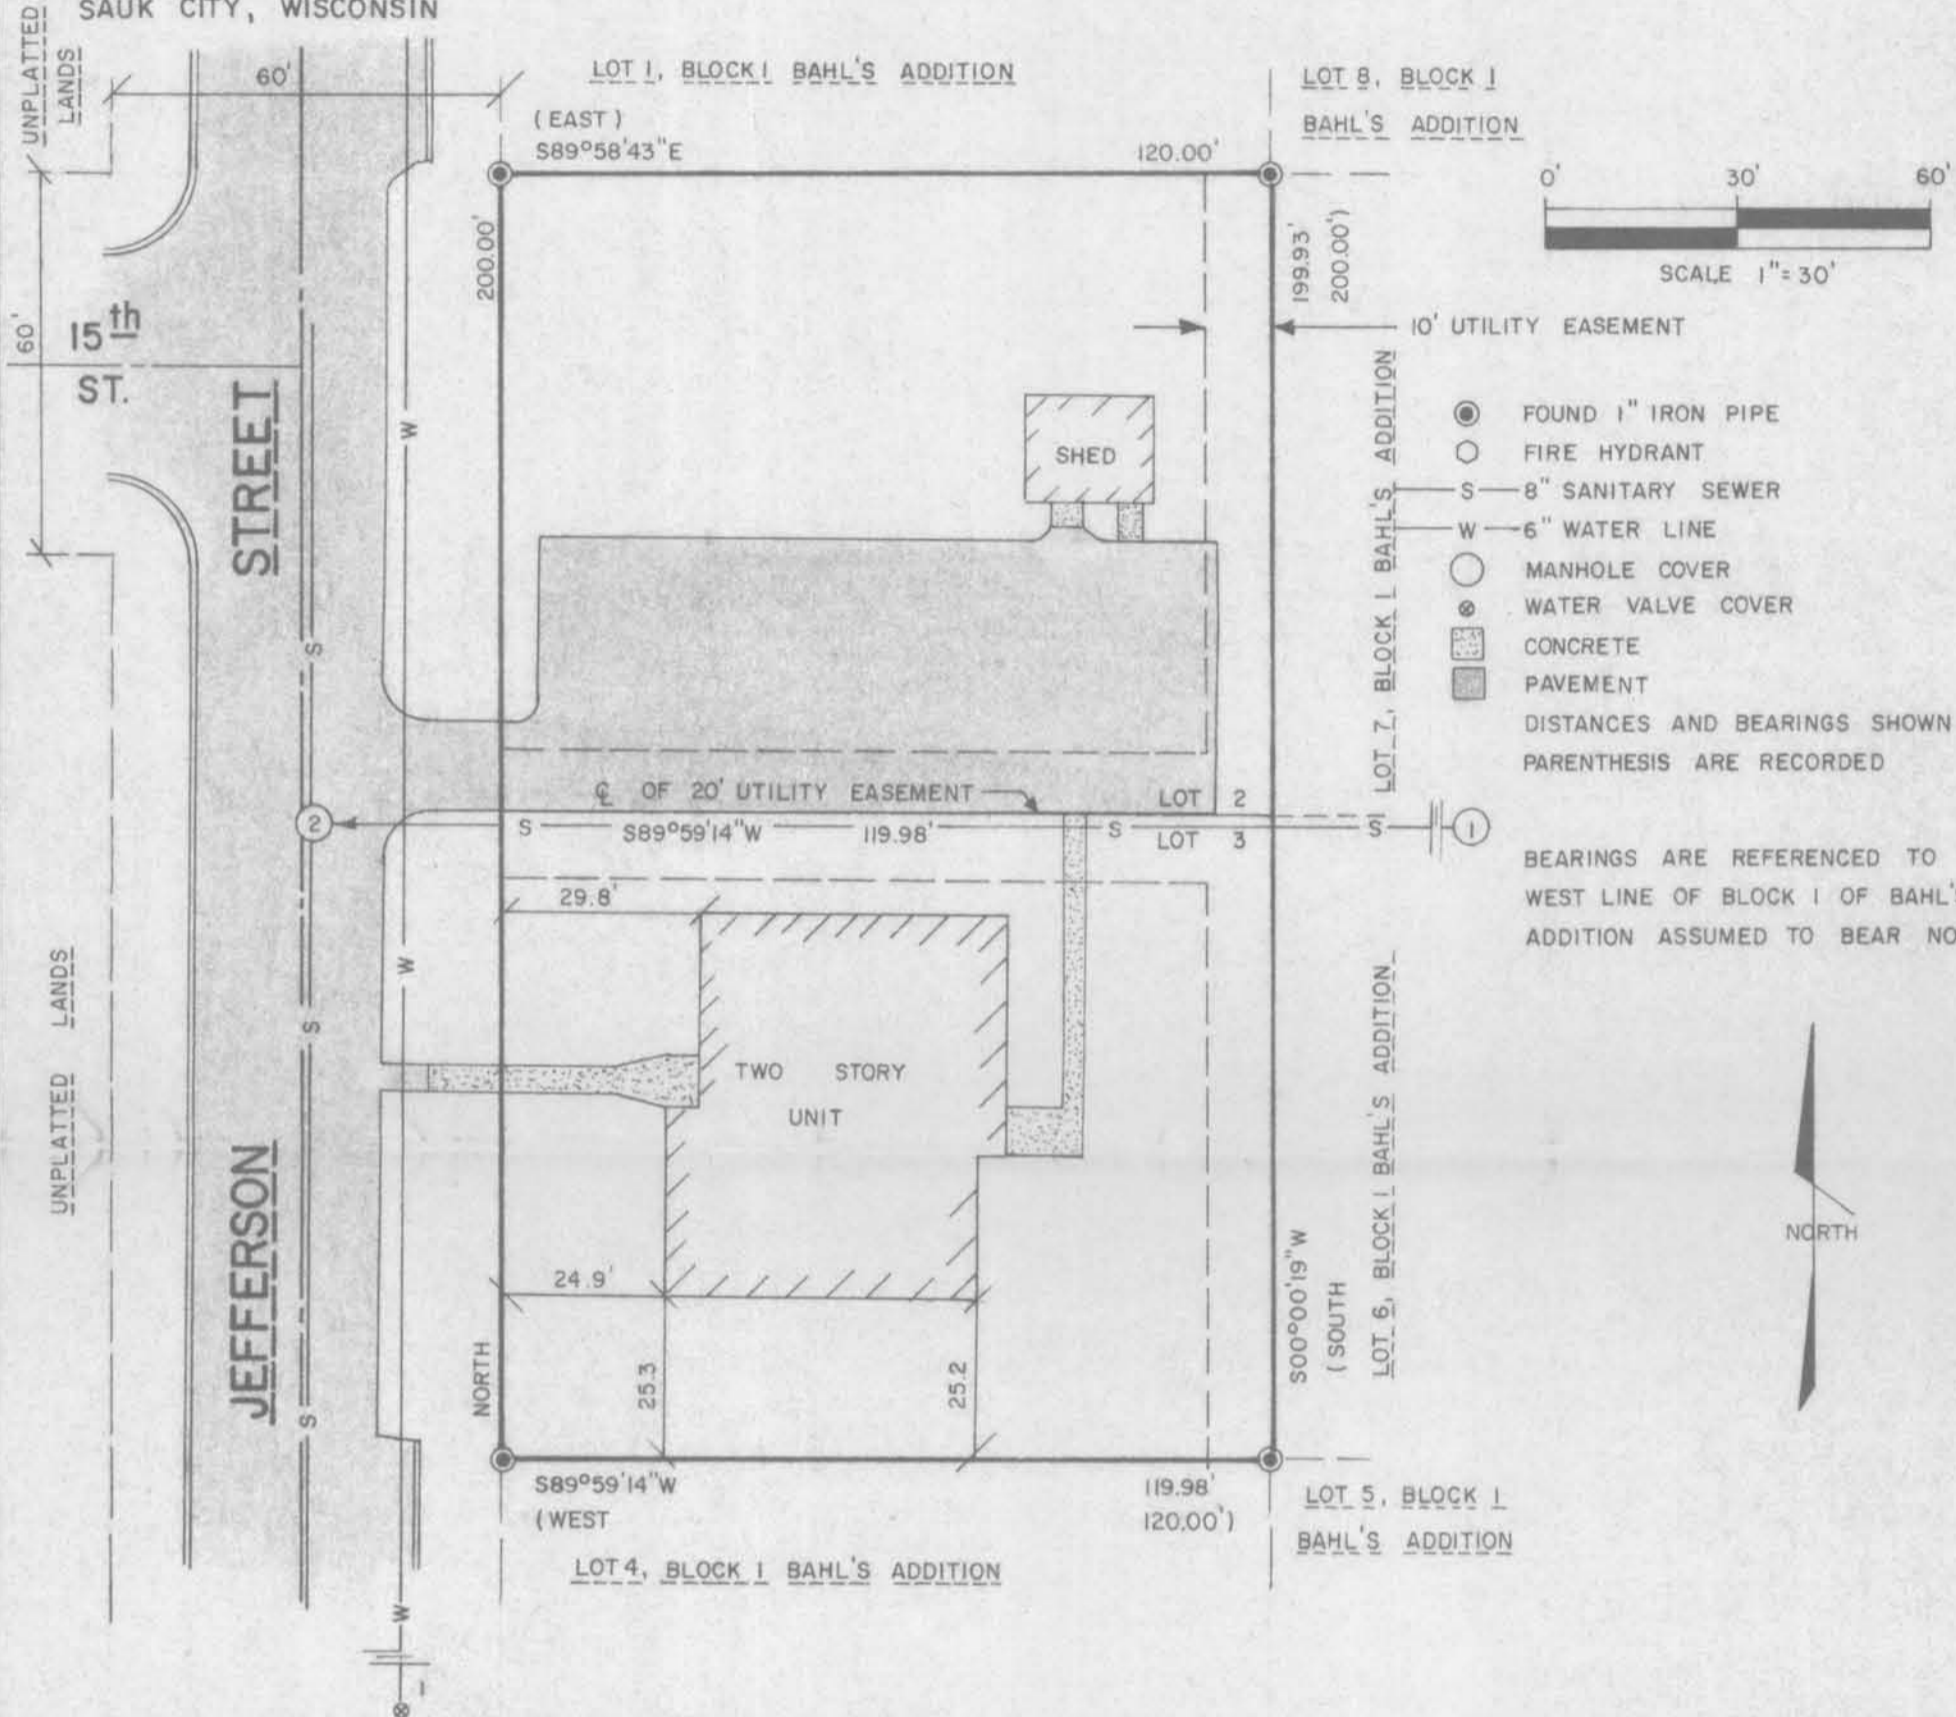

Sewer Elevations

Manhole Number	Rim Elevation	Flow Line
1	105.5	95.9
2	93.8	86.3

Water Elevation		
1	95.1	90.1

This area is zoned R-3 and is subject to the following setbacks:

- Front Yard - 20 ft.
- Rear Yard - 20 ft.
- Side Yard - 8 ft.

I, Richard Marks, Registered Land Surveyor, do hereby certify that I have surveyed, mapped and shown all easements and building locations for the above shown parcel from the descriptions furnished to me. This parcel being more particularly described as:

Lots Two (2) and Three (3) of Block One (1), Bahl's Addition to the City of Fennimore, Grant County, Wisconsin.

That I have surveyed and mapped such parcel under the direction of Lloyd Mattix. That such survey is accurate and correct to the best of my knowledge and belief.



Richard Marks
Richard Marks, S-1473