

MORTGAGE INSPECTION REPORT  
FOR

LOTS 1 AND 2 IN BLOCK 4 OF ROOD'S ADDITION TO THE VILLAGE OF  
HAZEL GREEN, GRANT COUNTY, WISCONSIN.

STATE OF WISCONSIN)  
COUNTY OF GRANT ) SS


SURVEYOR'S CERTIFICATE

I, PAUL C. BRASHAW, A WISCONSIN REGISTERED LAND SURVEYOR, NO. S-1509, DO HEREBY CERTIFY THAT AT THE REQUEST OF DAIVA CAPLENAS OF ANCHOR SAVINGS AND LOAN ASSOCIATION OF MADISON, WISCONSIN, I HAVE BEEN FURNISHED THE ABOVE DESCRIBED LEGAL DESCRIPTION, AND THAT I HAVE MADE A MORTGAGE INSPECTION REPORT FOR THE ABOVE DESCRIBED TRACT, AND THAT I HAVE LOCATED THE IMPROVEMENTS ON THIS PROPERTY, AND THAT THERE ARE NO APPARENT ENCROACHMENTS EXCEPT AS SHOWN ON THE ACCOMPANYING DRAWING. IT SHOULD BE NOTED THAT IN THE PERFORMANCE OF THIS MORTGAGE INSPECTION REPORT, NO MONUMENTATION WAS SET AND THAT ALL REQUIREMENTS PERTAINING TO THE MINIMUM STANDARDS FOR THE WISCONSIN STATE STATUTES HAVE BEEN WIAVED AND THAT ALL TIES ARE MEASURED TO EXISTING LOT LINES ALL AS SHOWN ON THE ACCOMPANYING DRAWING.

SIGNED AND SEALED THIS 20TH DAY OF OCTOBER, 1 983.

*Paul C Brashaw*

PAUL C. BRASHAW  
WISCONSIN REGISTERED LAND SURVEYOR  
NO. S-1509

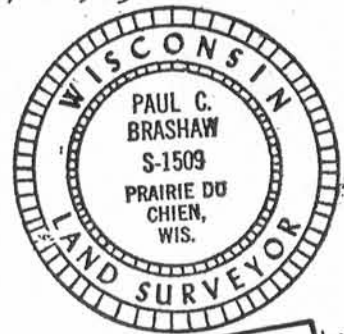

0.00°  
(0.00°)

MEASURED DISTANCE/BEARING  
PLATTED DISTANCE/BEARING  
BOUNDARY OF PROPERTY  
IRON MONUMENT FOUND



SCALE : 1" = 30'

PREPARED FOR  
DAIVA CAPLENAS  
ANCHOR SAVINGS AND LOAN  
25 WEST MAIN ST.  
MADISON, WISCONSIN 53703

RODNEY SMITH  
3025 N. PERCIVAL  
HAZEL GREEN, WISCONSIN

SNYDER BRASHAW ENGINEERING  
1601 S. MARQUETTE ROAD  
PRAIRIE DU CHIEN, WISCONSIN 53821  
TELEPHONE (608) 326-8448

DATE: OCTOBER 20, 1983