


# Richard S. Osborn, P.E. R.L.S.

217 Maureen Avenue  
 Dickeyville, Wisconsin 53535  
 (608) 568-7995

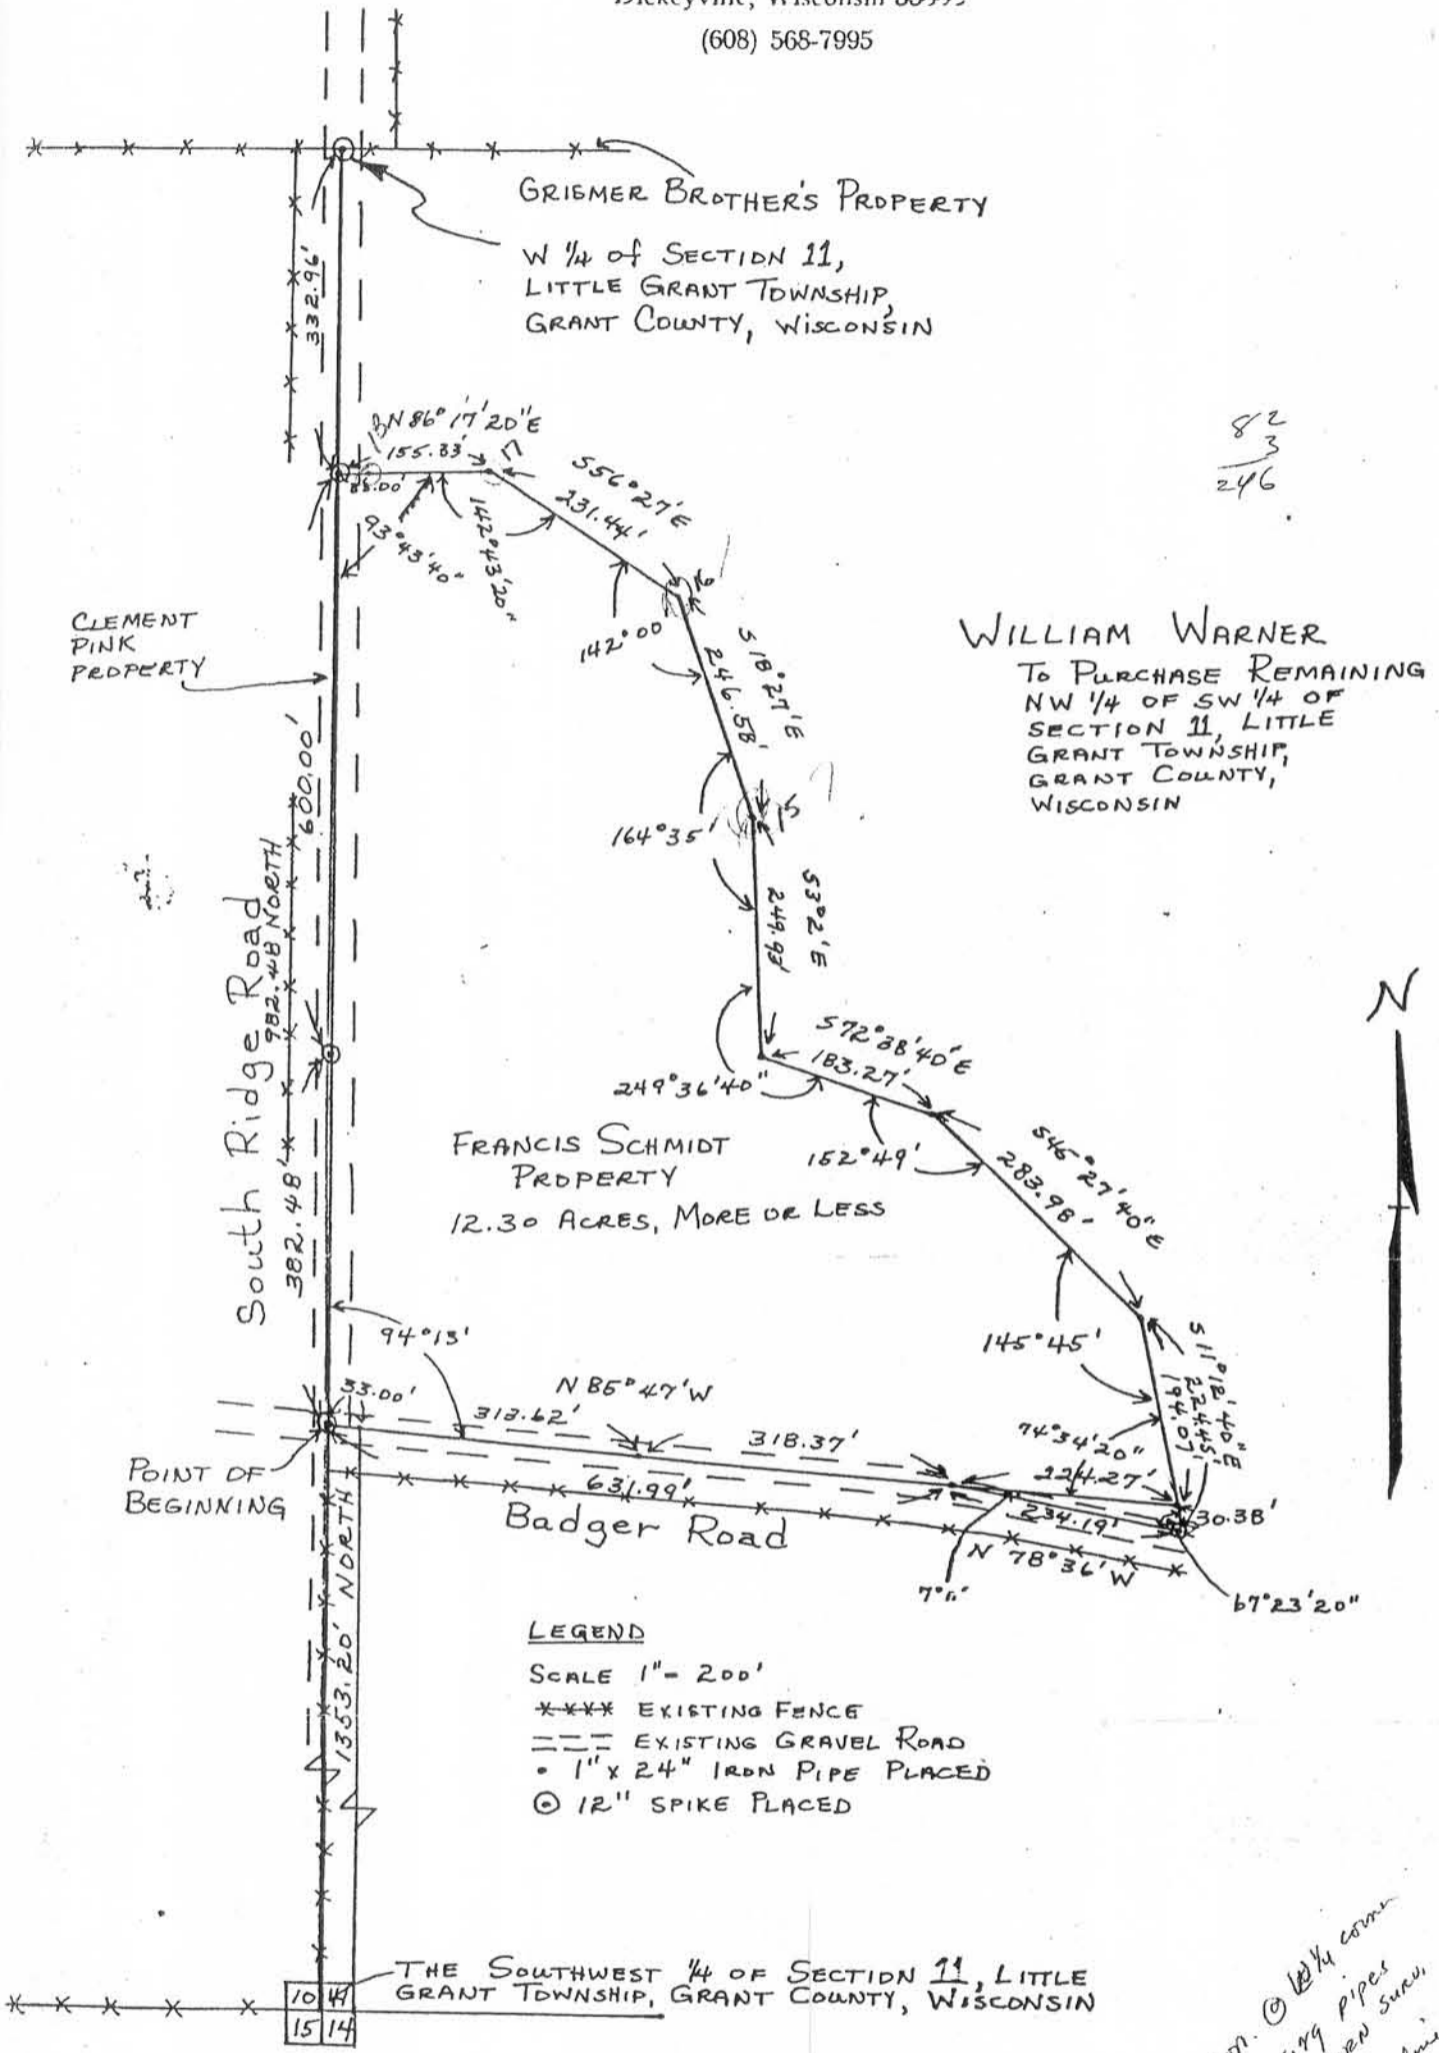

① Set mon. © 1/4 corner  
 ② Show exist. 1 1/4 pipes  
 ③ Set NE corner  
 between the

Richard S. Osborn, P.E. R.L.S.

217 Maureen Avenue  
Dickeyville, Wisconsin 53808  
(608) 568-7995

May 13, 1977

FRANCIS SCHMIDT SURVEY

A parcel of land located in the Northwest  $\frac{1}{4}$  (one-quarter) of the Southwest  $\frac{1}{4}$  (one-quarter) of Section 11, Little Grant Township, Grant County, Wisconsin. Described as follows:

Commencing at the Southwest  $\frac{1}{4}$  (one-quarter) of Section 11 Township 5 North, Range 4 West of the Fourth Principle Meridian;

Thence North 1,353.20' to the Point of Beginning which is also the intersection point of Badger Road running East/West and South Ridge Road which runs North from this point;

Thence continuing North along the Centerline of said townroad 982.48 feet;

Thence North  $86^{\circ}17'20''$  East 155.33 feet;

Thence South  $56^{\circ}27'$  East 231.44 feet;

Thence South  $18^{\circ}27'$  East 246.58 feet;

Thence South  $3^{\circ}2'$  East 249.93 feet;

Thence South  $72^{\circ}38'40''$  East 183.27 feet;

Thence South  $45^{\circ}27'40''$  East 283.98 feet;

Thence South  $11^{\circ}12'40''$  East 224.45 feet;  
to Center Line of Badger Road;

Thence North  $78^{\circ}36'$  West 234.19 feet;

Thence North  $85^{\circ}47'$  West 631.99 feet to the Point of Beginning;

Containing 12.30 Acres, more or less.

I hereby certify that I have surveyed the above described parcel of land at the direction of William Warner for Francis Schmidt and that it is an accurate survey and true representation thereof and correctly shows the exterior boundary lines in said parcel.

Date 5/17/77

*Richard Scott Osborn*

Richard Scott Osborn  
Registered Land Surveyor  
No. 1233