



POLE
ELECT., TELE., CABLE T.V.
● TRANSFORMER

ELECTRIC LINE
3 WIRE SECONDARY
3 WIRE PRIMARY


NATURAL GAS—NOT AVAILABLE IN CASSVILLE

WATER—WATER PRESSURE 80 psi

LEGEND:

- 1"x24" IRON PIPE PLACED BY THIS SURVEY
- ⊗ CHISEL MARK MADE BY THIS SURVEY
- ⊕ TREE WITH DIAMETER MANHOLE
- ⊖ I.E. INVERT ELEVATION
- + ELEVATION SHOT
- ELECTRICAL POLE
- ELECTRICAL LINE
- WATER MAIN
- SANITARY SEWER
- CURB AND GUTTER
- CURB STOP (CS)
- STORM SEWER
- PROPERTY LINE
- CENTERLINE
- WATER VALVE
- WATER HYDRANT
- WATER BUBBLER
- SIGN
- LOT LINE

SCALE: 1" = 10'

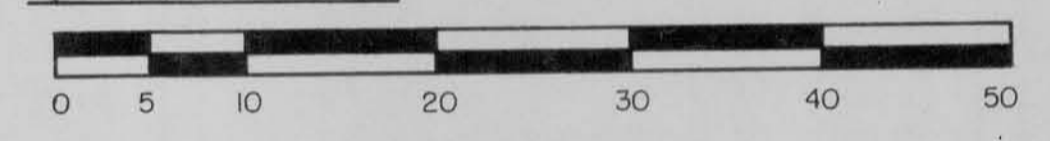

BADGER STATE BANK SURVEY

DESCRIPTION

LOTS SIX(6) AND SEVEN(7), BLOCK NINE(9) OF THE ORIGINAL PLAT OF THE VILLAGE OF CASSVILLE, GRANT COUNTY, WISCONSIN, EXCEPT THE EASTERLY 12 FEET OF SAID LOT SEVEN(7), ACCORDING TO THE RECORDED MAP OR PLAT THEREOF.

CERTIFICATE:

STATE OF WISCONSIN) S.S.
COUNTY OF GRANT)
I, HOMER D. RALPH JR. HEREBY CERTIFY THAT I HAVE SURVEYED OR DIRECTED THE SURVEYING OF LOT SIX(6) AND PART OF LOT SEVEN(7) IN BLOCK NINE(9) ACCORDING TO THE ORIGINAL PLAT OF THE VILLAGE OF CASSVILLE, GRANT COUNTY, WISCONSIN, AND THAT THIS MAP IS A TRUE AND CORRECT REPRESENTATION OF SUCH SURVEY.

DATE: 7/7/75



Homer D. Ralph Jr.
HOMER D. RALPH JR.
REGISTERED LAND SURVEYOR
S-141