


LA = 271° 20'


J.P. 21

66 Elm ST.

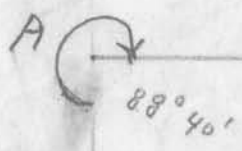

center of sec 3-4-3

TYLER

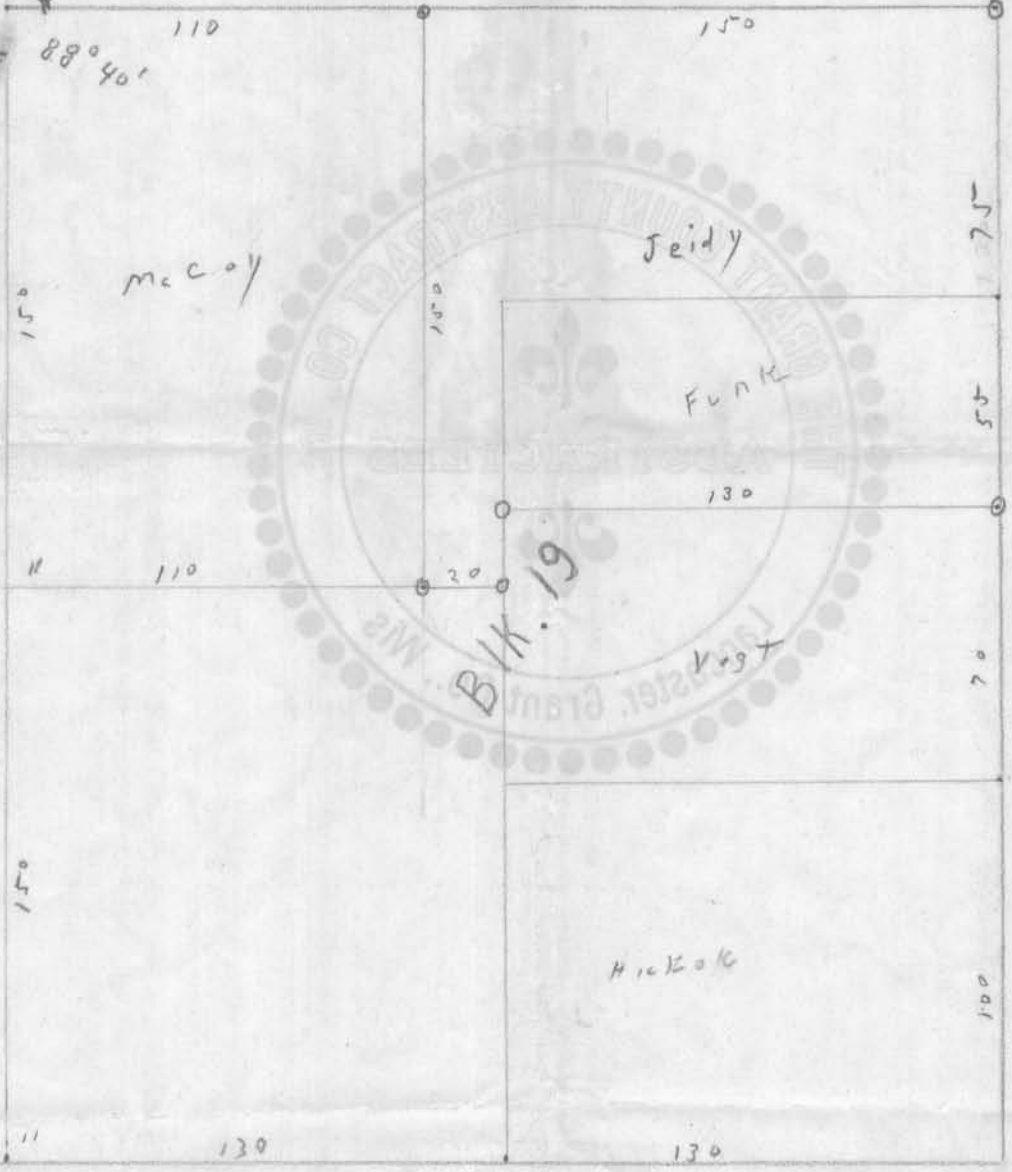

Harrison

Hickory ST.

47 1/2

A. P. Lancaster