

SURVEY PLAT


HOVELSRUD CONSULTING ASSOCIATES
ENGINEERING - LAND SURVEYING
RICHLAND COUNTY BANK BUILDING
RICHLAND CENTER, WISCONSIN 53581

Survey For: Robert Patros

April 28, 1977

Sheet 2 of 2

Parcel located in the Southeast Quarter (SE $\frac{1}{4}$) of the Southeast Quarter (SE $\frac{1}{4}$) of Section 18, T.87N., R.2 W., Grant County, Wisconsin

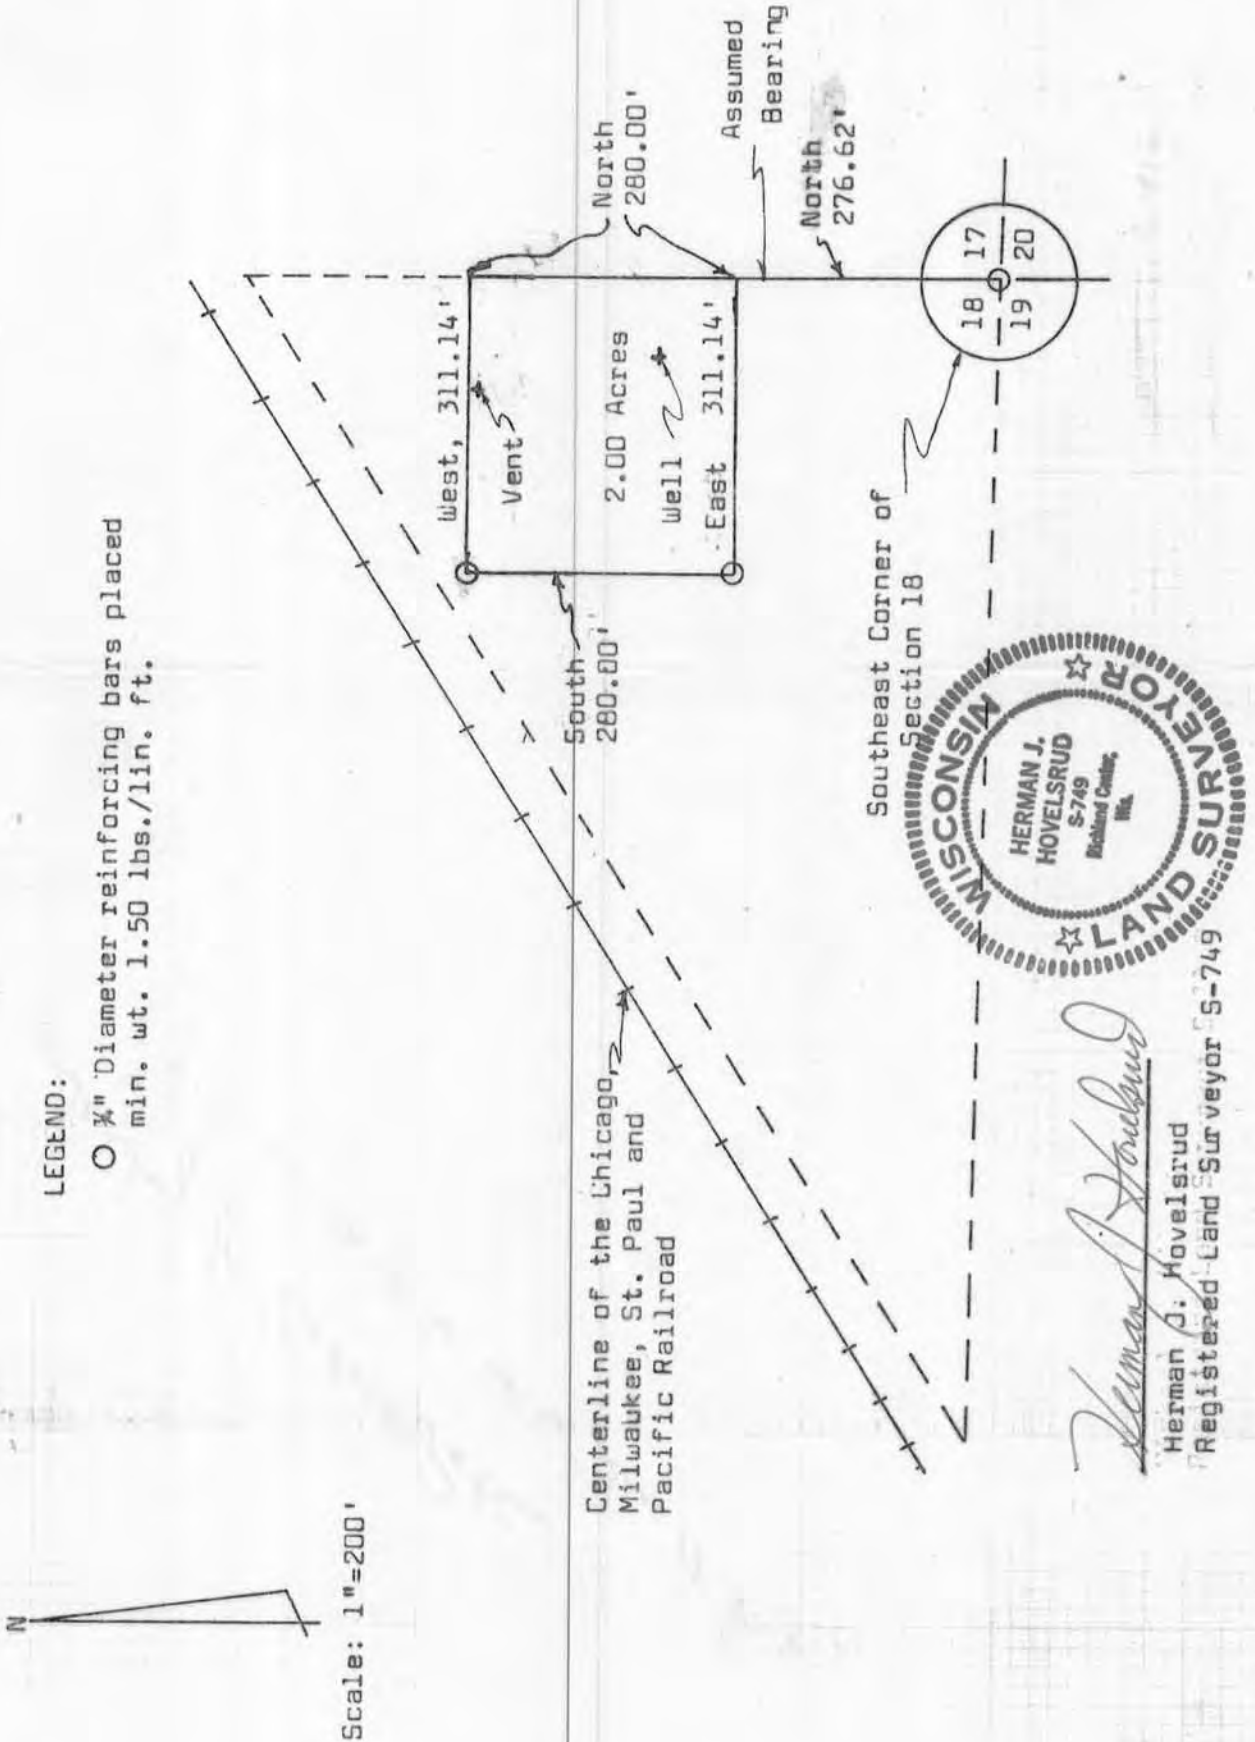

SURVEY PLAT

HOVELSRUD CONSULTING ASSOCIATES
ENGINEERING - LAND SURVEYING
RICHLAND COUNTY BANK BUILDING
RICHLAND CENTER, WISCONSIN 53581

SURVEY FOR: Robert Patros

April 28, 1977

Sheet 1 of 2

A SURVEY OF A PARCEL OF LAND DESCRIBED AS FOLLOWS:


Commencing at a 3/4 inch diameter reinforcing bar at the Southeast Corner of Section 18, T. 8 N., R. 2 W., Grant County, Wisconsin; Thence North 276.62 feet to the point of beginning;

Thence North 280.00 feet;
Thence West 311.14 feet to a 3/4 inch diameter reinforcing bar;
Thence South, 280.00 feet to a 3/4 inch diameter reinforcing bar;
Thence East 311.14 feet to the point of beginning;

The above described parcel of land being located in the Southeast Quarter (SE $\frac{1}{4}$) of the Southeast Quarter (SE $\frac{1}{4}$) of Section 18, T. 8 N., R. 2 W., Grant County, Wisconsin and containing 2.00 acres.

I certify that I have surveyed the above described parcel of land and that the following Plat is an accurate survey and a true representation thereof and correctly shows the exterior boundary lines of said parcel and the correct measurements thereof to the best of my knowledge and belief.

Dated this 17th day
of May, 1977
Richland Center, Wisconsin

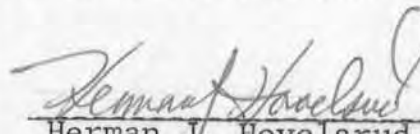
Herman J. Hovelsrud
Registered Land Surveyor S-749



3359.001

242