

SURVEY PLAT


HOVELSRUD CONSULTING ASSOCIATES
ENGINEERING - LAND SURVEYING
RICHLAND COUNTY BANK BUILDING
RICHLAND CENTER, WISCONSIN 53581

Survey for: Francis Derrickson

June 15, 1976

Sheet 2 of 2

Parcel located in the Southwest Quarter (SW $\frac{1}{4}$) of the Northwest Quarter (NW $\frac{1}{4}$) of Section 13, 1. 8 N., R. 2 W., Grant County, Wisconsin.

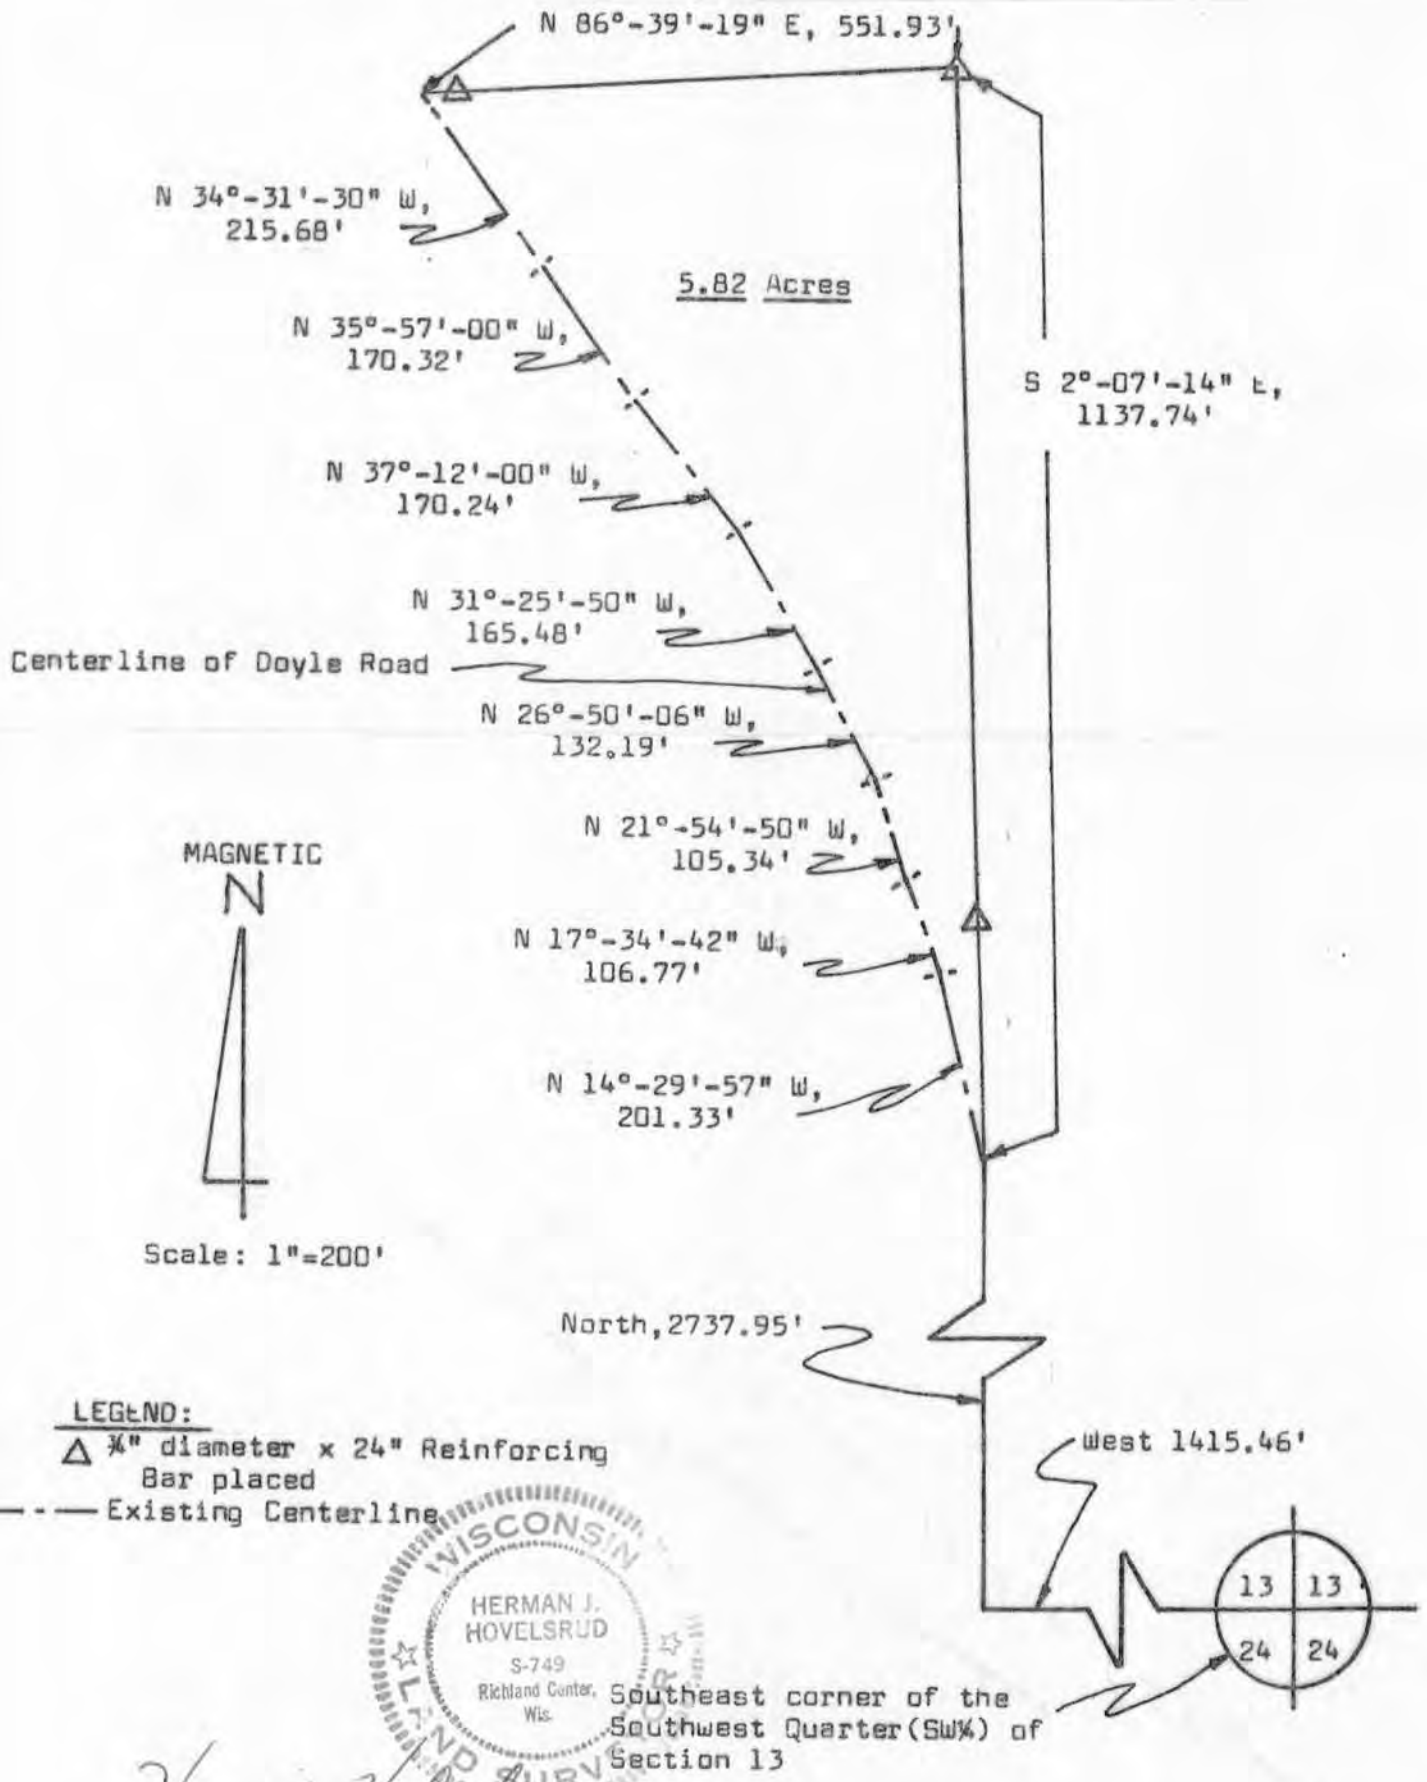

Herman J. Hovelsrud
 Herman J. Hovelsrud
 Registered Land Surveyor S-749

SURVEY PLAT

HOVELSRUD CONSULTING ASSOCIATES
ENGINEERING - LAND SURVEYING
RICHLAND COUNTY BANK BUILDING
RICHLAND CENTER, WISCONSIN 53581

SURVEY FOR: Francis Derrickson

June 15, 1976

Sheet 1 of 2

A SURVEY OF A PARCEL OF LAND DESCRIBED AS FOLLOWS:

Commencing at the Southeast Corner of the Southwest Quarter (SW $\frac{1}{4}$) of Section 13, T. 8 N., R. 2 W., Grant County, Wisconsin; Thence West, 1415.46 feet; Thence North, 2737.95 feet to a point in the centerline of Doyle Road and the point of beginning;

Thence N 14°-29'-57" W, 201.33 feet to a point in said centerline;

Thence N 17°-34'-42" W, 106.77 feet to a point in said centerline;

Thence N 21°-54'-50" W, 105.34 feet to a point in said centerline;

Thence N 26°-50'-06" W, 132.19 feet to a point in said centerline;

Thence N 31°-25'-50" W, 165.48 feet to a point in said centerline;

Thence N 37°-12'-00" W, 170.24 feet to a point in said centerline;

Thence N 35°-57'-00" W, 170.32 feet to a point in said centerline;

Thence N 34°-31'-30" W, 215.68 feet to a point in said centerline;


Thence N 86°-39'-19" E, 551.93 feet to a 3/4 inch diameter reinforcing bar;

Thence S 2°-07'-14" E, 1137.74 feet to the point of beginning;

The above described parcel of land being located in the Southwest Quarter (SW $\frac{1}{4}$) of the Northwest Quarter (NW $\frac{1}{4}$) of Section 13, T. 8 N., R. 2 W., Grant County, Wisconsin and containing 5.82 acres and being subject to conveyances for roadway purposes.

I certify that I have surveyed the above described parcel of land and that the following Plat is an accurate survey and a true representation thereof and correctly shows the exterior boundary lines of said parcel and the correct measurements thereof to the best of my knowledge and belief.

Dated this 7th day
of July, 1976
Richland Center, Wisconsin

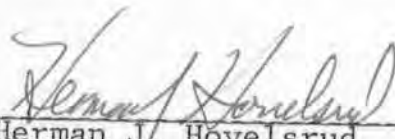
Herman J. Hovelsrud
Registered Land Surveyor S-749

