




DETAIL OF BUILDING LOCATION ON R & R STORAGE PROPERTY

A PART OF LOT 11 OF BLOCK 5 OF THE ASSESSMENT  
PLAT OF PLATTEVILLE, WISCONSIN

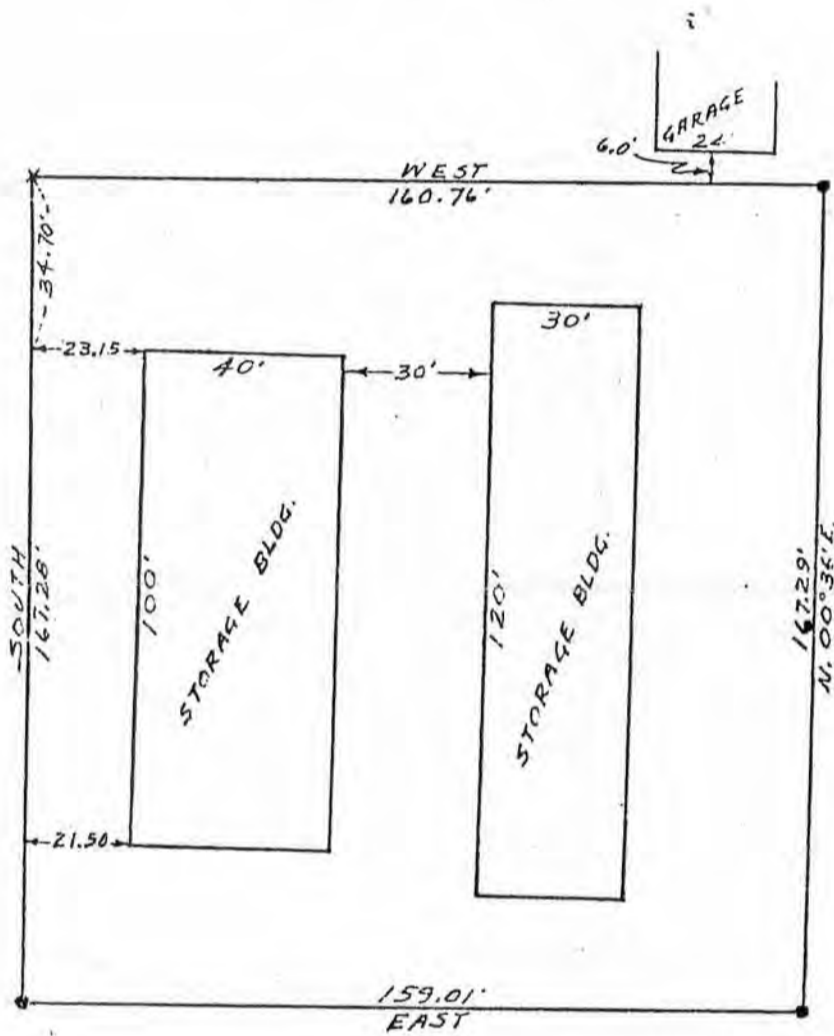

SCALE: 1" = 40'  
● 1" x 24" IRON PIPE  
x RR SPIKE IN PAVEMENT



I, John F. Orth, Registered Land Surveyor, hereby certify that I surveyed the property shown on the above plat and that this is a true representation of the result of said survey.

*January 24/1983*  
Dated

*John F. Orth*  
John F. Orth RLS-340