


BLUM-SURVEY

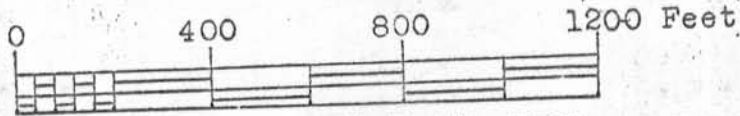

SCALE 1" = 400'

- Rock 4"x8" previously placed corner of Sections 26, 27, 34, 35, T4N, R6W, 4th P.M., Grant Co., Wis.
- 1"x24", 1.13 Lbs/Lin. Ft. iron pipe placed by this survey.

W ——— E

S

27 26  
34 35

South 2640'

John Rauch

John Rauch

West 1320.00'  
Existing Fence line.

Kaufman

Lawrence Blum

N.W. 1/4 of S.E. 1/4  
of Sec. 34, T 4 N,  
R 6 W. of the 4th  
P.M., Grant Co.,  
Wis.

South 1320.00'

*Thomas S. Bainbridge*  
Thomas S. Bainbridge  
4/18/68-5/25/68

*Homer D. Ralph, Jr.*  
Homer D. Ralph, Jr.  
Surveyor for Grant Co., Wis.  
Wis. Reg. No. S-141