


DESCRIPTION: A Survey of Lots 13, 14, 15 and 16 of Block 116, Original Plat of the Village of Muscoda, Grant County, Wisconsin.

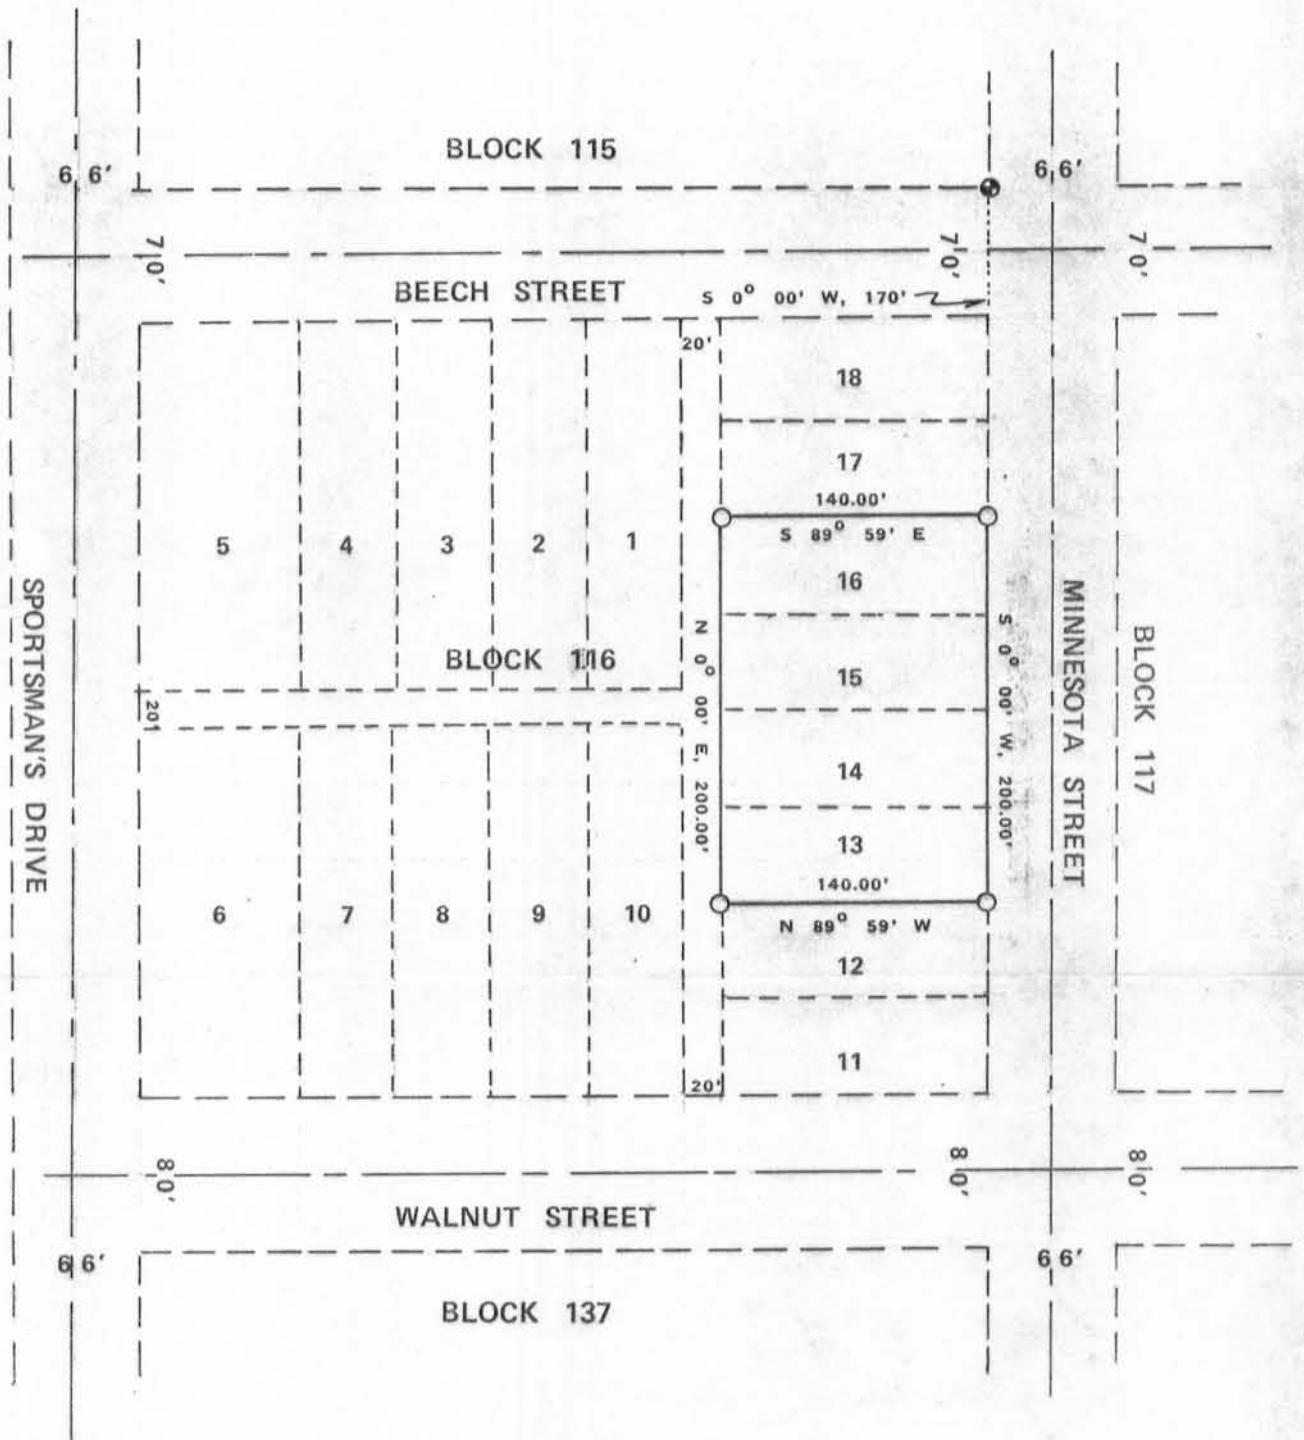

Bearing Referenced to the West Line of Minnesota Street Assumed N 0° 00' E

Scale - 1" = 100'

● - Found 1" Round Reinforcing Bar

○ - Set 1" x 24" Iron Pipe weighing 1.13 lbs./lineal ft.

I certify that I have surveyed the above described parcel of land and that the above plat is a true representation thereof to the best of my belief.

*Dennis D. Hoagland*  
Dennis D. Hoagland 6/14/80  
Registered Land Surveyor S-1555

