


PLAT OF SURVEY

SURVEY FOR: Bob Griffin

October 16, 1980

Lots 1 and 2, Block 143, Plat of Village of Muscoda, Grant County, Wisconsin.

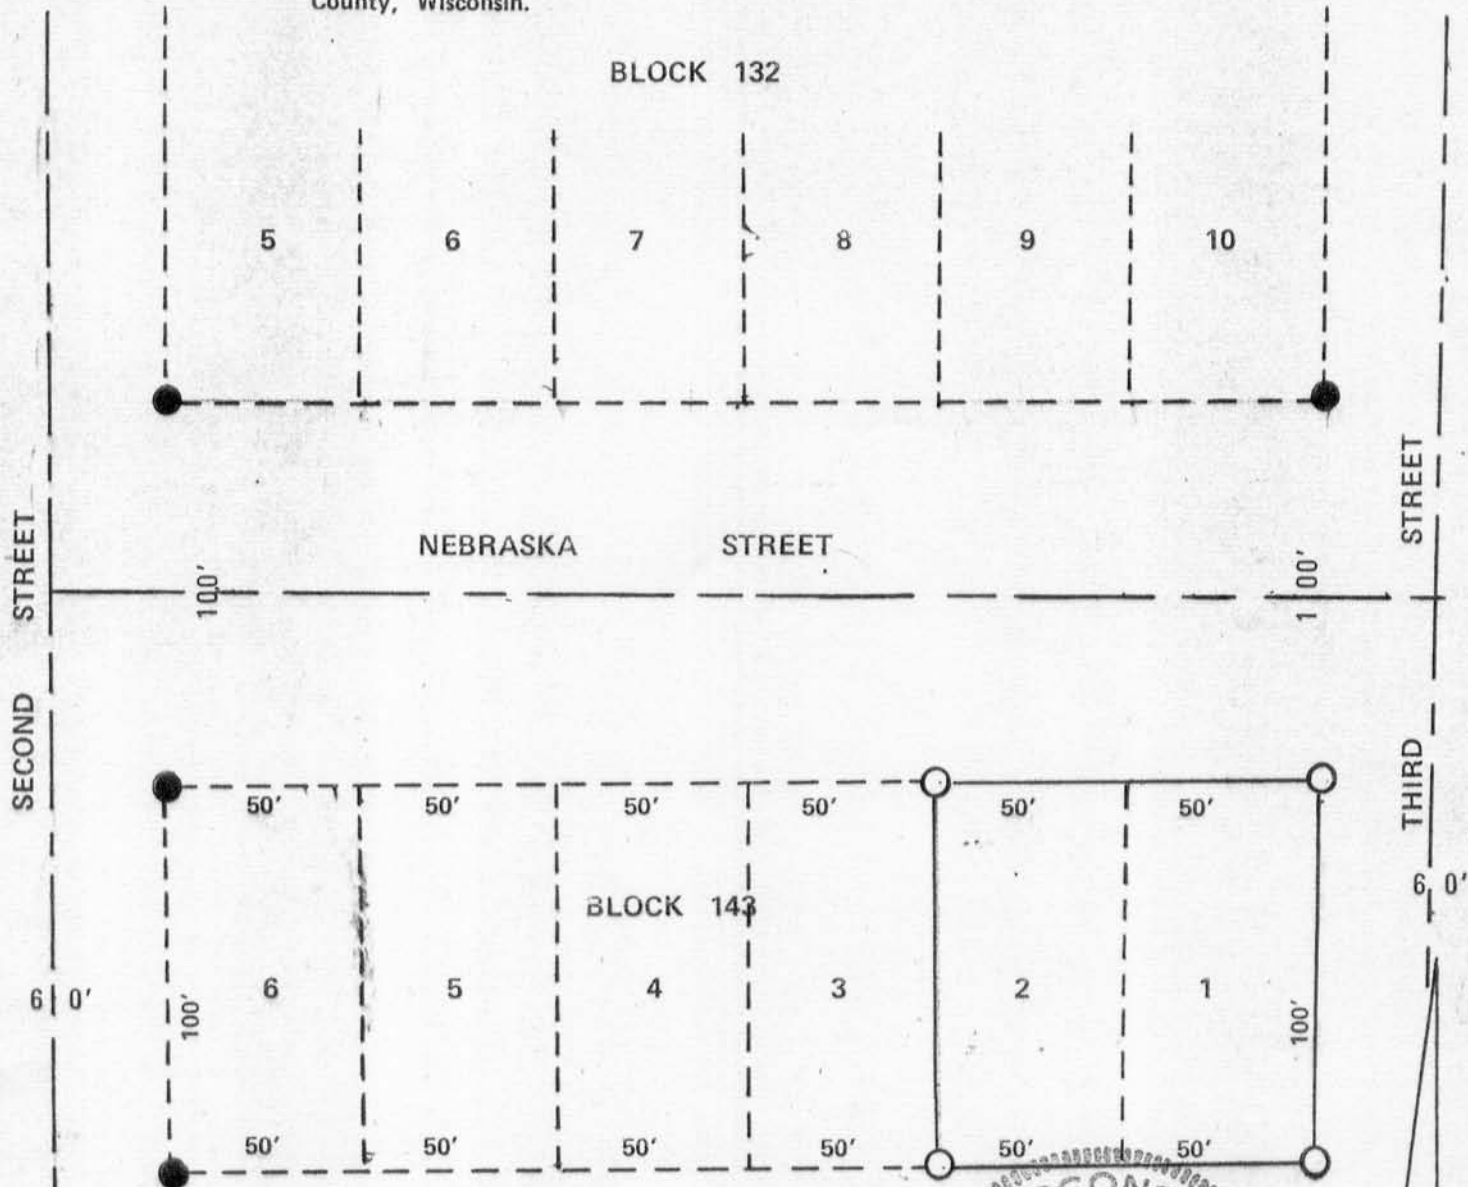

- - Iron Stakes Located
- - 1" x 24" Iron Pipe Placed



I certify that I have located and/or placed the above shown pipe and that the above plat is a true representation thereof.

*Michael C. McMillin*

Michael C. McMillin  
Registered Land Surveyor S-1179

