

B. 7 2802 (1/3)
Copy for Jim

H. J. HOVELSRUD
CIVIL ENGINEER · LAND SURVEYOR
RICHLAND CENTER, WISCONSIN 53581

Survey for: Attorney James Azim

October 12, 1968


A SURVEY of a PARCEL of LAND Located in the Village of Muscoda, Grant County, Wisconsin, that is Described as Follows:

The East 47.8 feet of Lot 1 of Block 166, the portion of Fourth Street that is located between Lot 1 of Block 166 and Lot 7 of Block 167, and lots 1, 2, 3, 4, 5, and 6 of Lot 167, all in the Village of Muscoda, Grant County, Wisconsin.




LEGEND

- O 1" ϕ x 24" Iron Pipe Placed
- BL Block Line
- LL Lot Line
- # Property Line

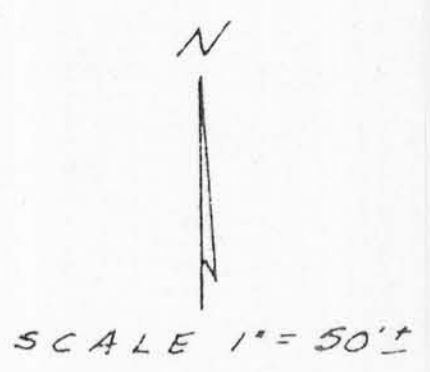

Warehouse street

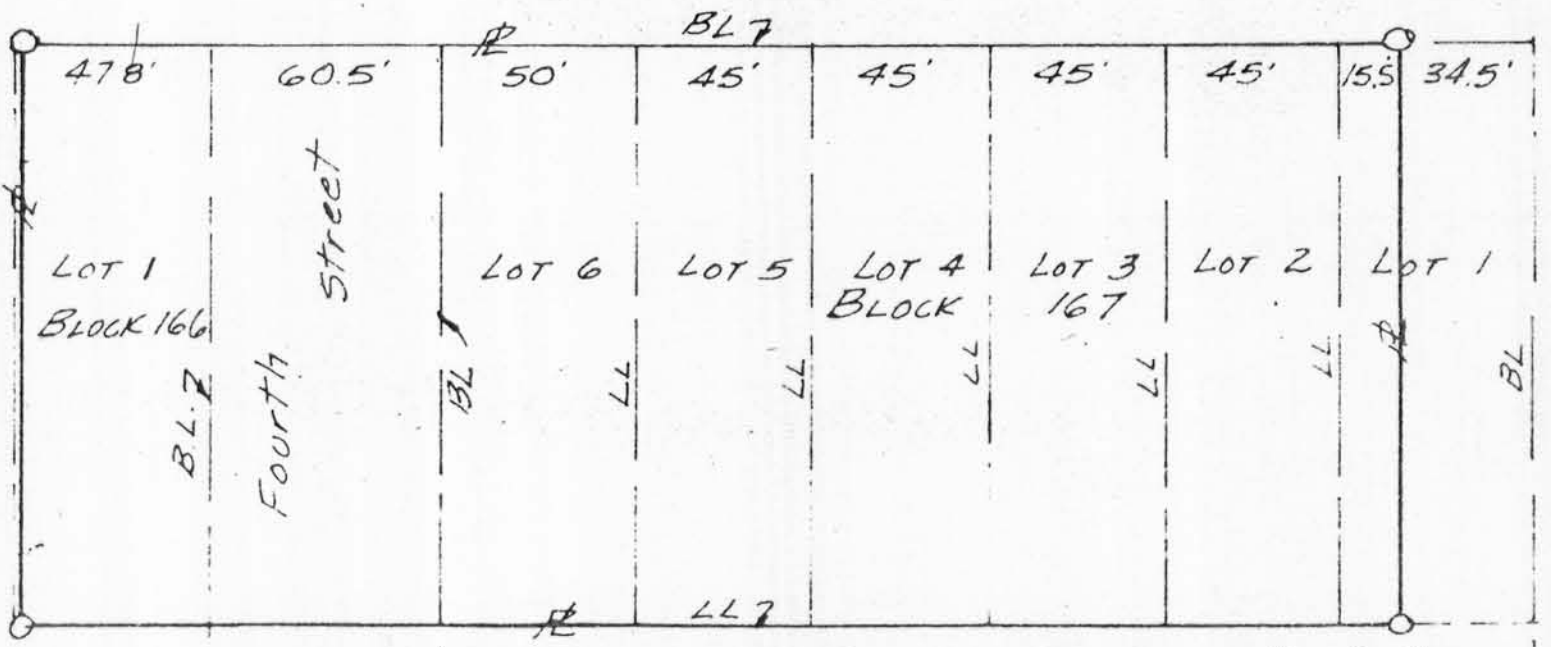

Block 166 and Block 167 are part of the VILLAGE OF MUSCODA, GRANT COUNTY, WISCONSIN

I certify that I have surveyed the above described parcel of land and that the above plat is an accurate survey and a true representation thereof and correctly shows the exterior boundary lines of said parcel and the correct measurements thereof.

Richland Center, Wisconsin
October 12, 1968

Herman J. Hovelsrud
Herman J. Hovelsrud
Registered Land Surveyor S-749