


HERBERT DEAN SURVEY

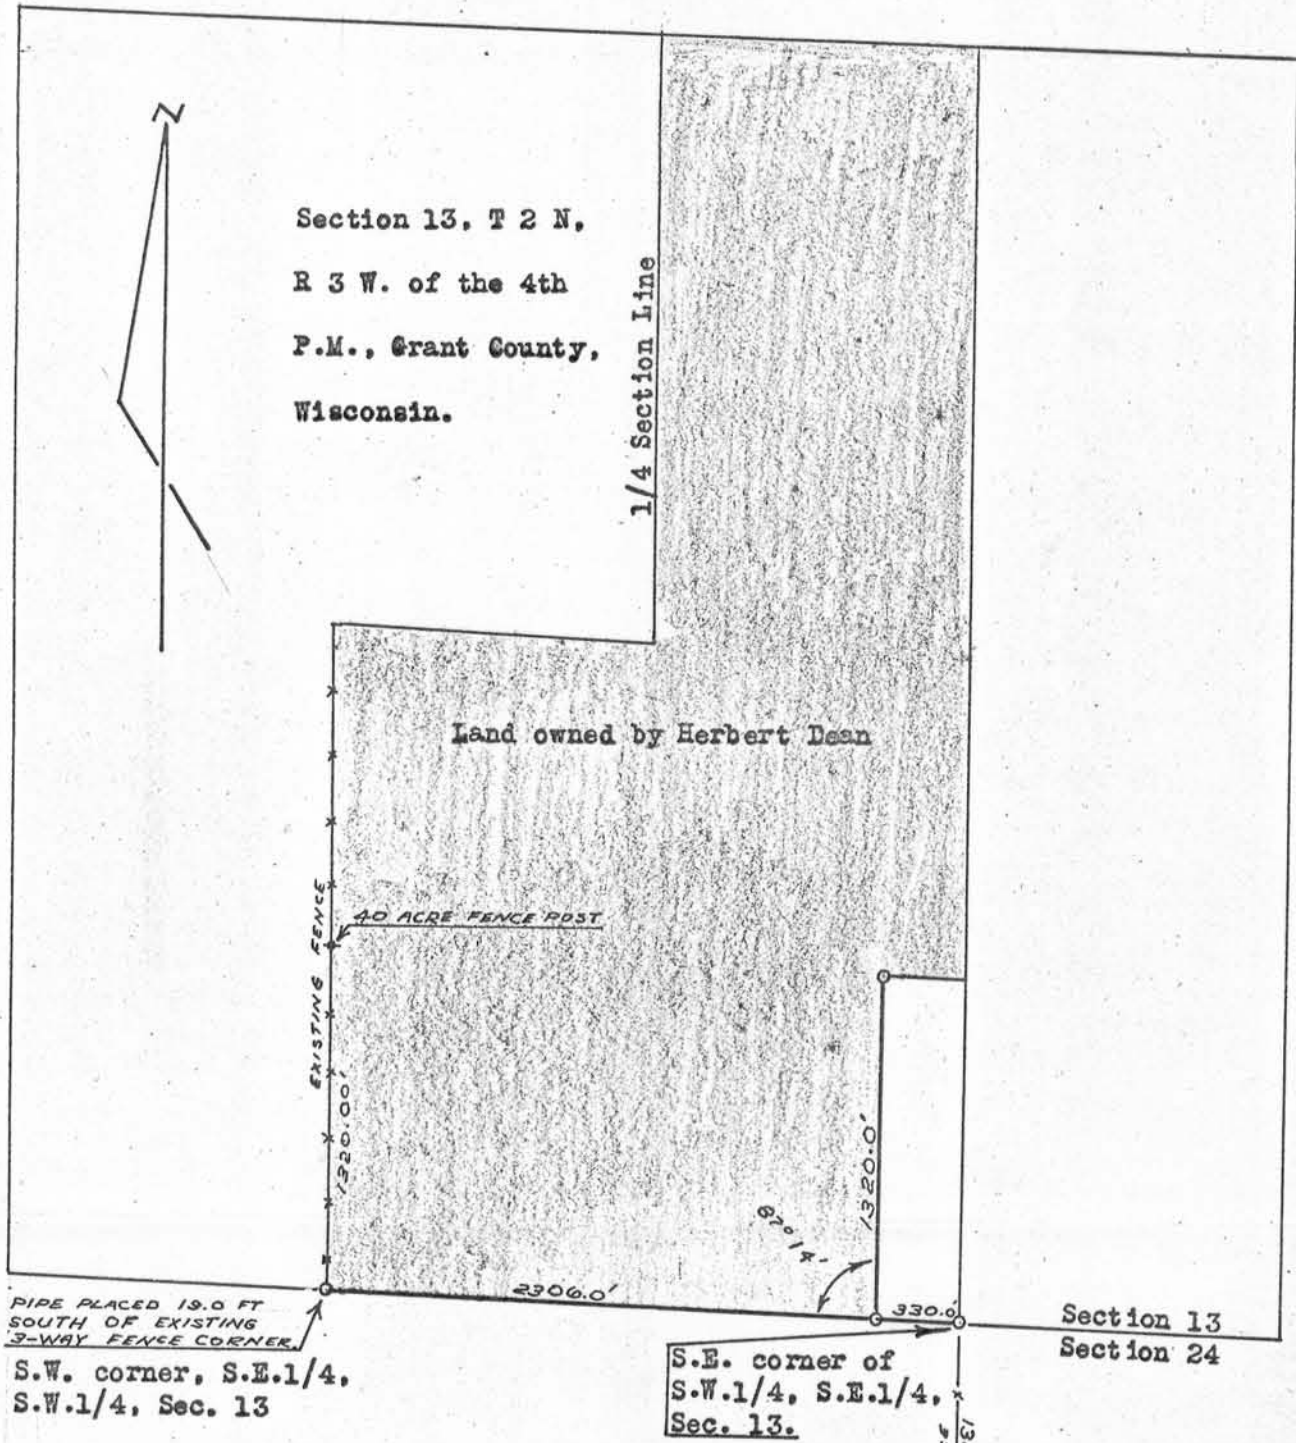

SCALE: 1" = 200'

o 1" X 24" Iron pipe placed by this survey.

Charles Lange
Charles Lange
5/25 - 7/14/72



Homer D. Ralph, Jr.
Homer D. Ralph, Jr.
Surveyor for Grant
County, Wisconsin.