


I CERTIFY THAT THIS SURVEY IS  
 CORRECT TO THE BEST OF MY  
 KNOWLEDGE AND BELIEF, AND THAT  
 I HAVE COMPLIED WITH STATE  
 AND LOCAL LAWS.

W. L. Clark.  
 R.L.S. No. 914

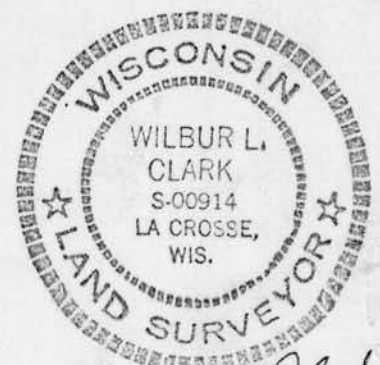

Wilbur L. Clark.  
 R.L.S. 914

Road: 0.373 ACRES.  
 Parcel: 4.290 ACRES.  
TOTAL: 4.663 ACRES.

ASSUMED  
 BEARING.  
 "EAST"  
 1,307.47'

<b>SURVEY FOR: MRS. ALVA MONEYPENNY</b> R.R. #2, FENNIMORE, WISCONSIN.		
SCALE: 1" = 100'	APPROVED BY:	DRAWN BY W.L.C.
DATE: 3-7-1977		REVISED
PARCEL OF LAND LOCATED IN THE S.E. 1/4 - N.E. 1/4 OF SECTION 21, T.6N., R.3W., 4TH P.M., TOWN OF MOUNT IDA, GRANT COUNTY, WISCONSIN.		
DATES OF SURVEY: 10-23-76 & 3-5-1977.		DRAWING NUMBER
© - 1/2" IRON PIPE SET.		