


IVAN JOHNSON SURVEY
 LIBERTY TOWNSHIP
 GRANT COUNTY, WIS.
 5/26/79

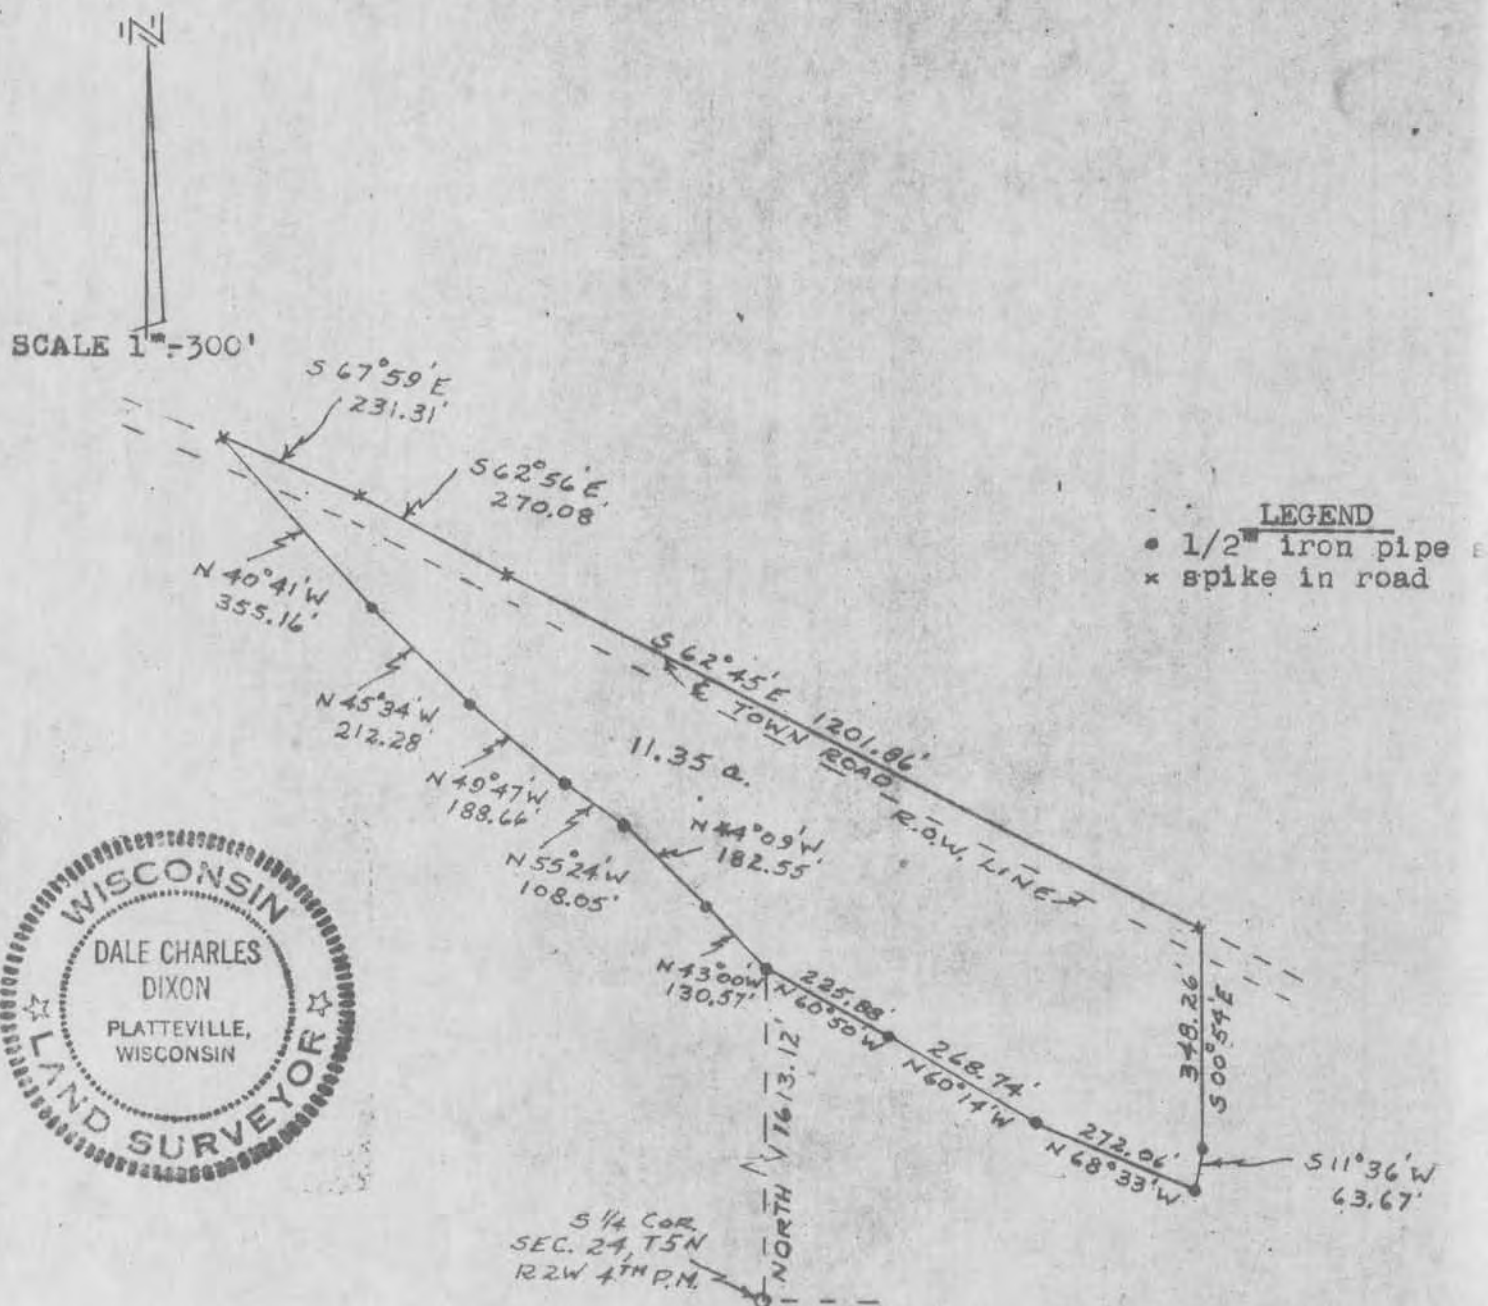

I, D.C. Dixon, registered surveyor, hereby certify that I surveyed the above land and that above plat is a correct representation thereof.

D.C. Dixon
 D.C. Dixon 8-304

DESCRIPTION:

commencing at the S $\frac{1}{4}$ corner of Sec. 24, T5N, R2W, 4th P.M. Grant County, Wisconsin; thence North, 1613.12 ft. to the point of beginning; thence N 43°00'W, 130.57 ft.; thence N 44°09'W, 182.55 ft.; thence N 55°24'W, 108.05 ft.; thence N 49°47'W, 188.66 ft.; thence N 45°34'W, 212.28 ft.; thence N 40°41'W, 355.16 ft. to the centerline of the township road; thence S 67°59'E, 231.31 ft. along said centerline; thence S 62°56'E, 270.08 ft. along said centerline; thence S 62°45'E, 1201.86 ft. along said centerline; thence S 00°54'E, 348.26 ft.; thence S 11°36'W, 63.67 ft.; thence N 68°33'W, 272.06 ft.; thence N 60°14'W, 268.74 ft.; thence N 60°50'W, 225.88 ft. to the point of beginning, containing 11.35 acres more or less. All being a part of the NE $\frac{1}{4}$ of the SW $\frac{1}{4}$ and the NW $\frac{1}{4}$ of the SE $\frac{1}{4}$ and a small part in the SW $\frac{1}{4}$ of the SE $\frac{1}{4}$ of Sec. 24, T5N, R2W, 4th P.M. Grant County, Wisconsin.

D.C. Dixon

S-304

D.C. Dixon

