


DESCRIPTION:

Commencing at the NE corner of the NW $\frac{1}{4}$ of the SE $\frac{1}{4}$ of Sec. 26, T5N, R2W, 4th P.1 Grant County, Wisconsin; thence East, 125.63 ft.; thence S 01°43'E, 94.14 ft.; thence S 00°05'W, 481.07 ft.; thence S 17°50'E, 325.06 ft.; thence S 67°34'W, 241.50 ft.; thence N 83°41'W, 283.05 ft.; thence N 20°28'W, 124.79 ft.; thence N 87°57'W, 456.31 ft.; thence N 16°39'E, 847.95 ft.; thence East, 533.95 ft. to the point of beginning, containing 16.52 acres more or less.

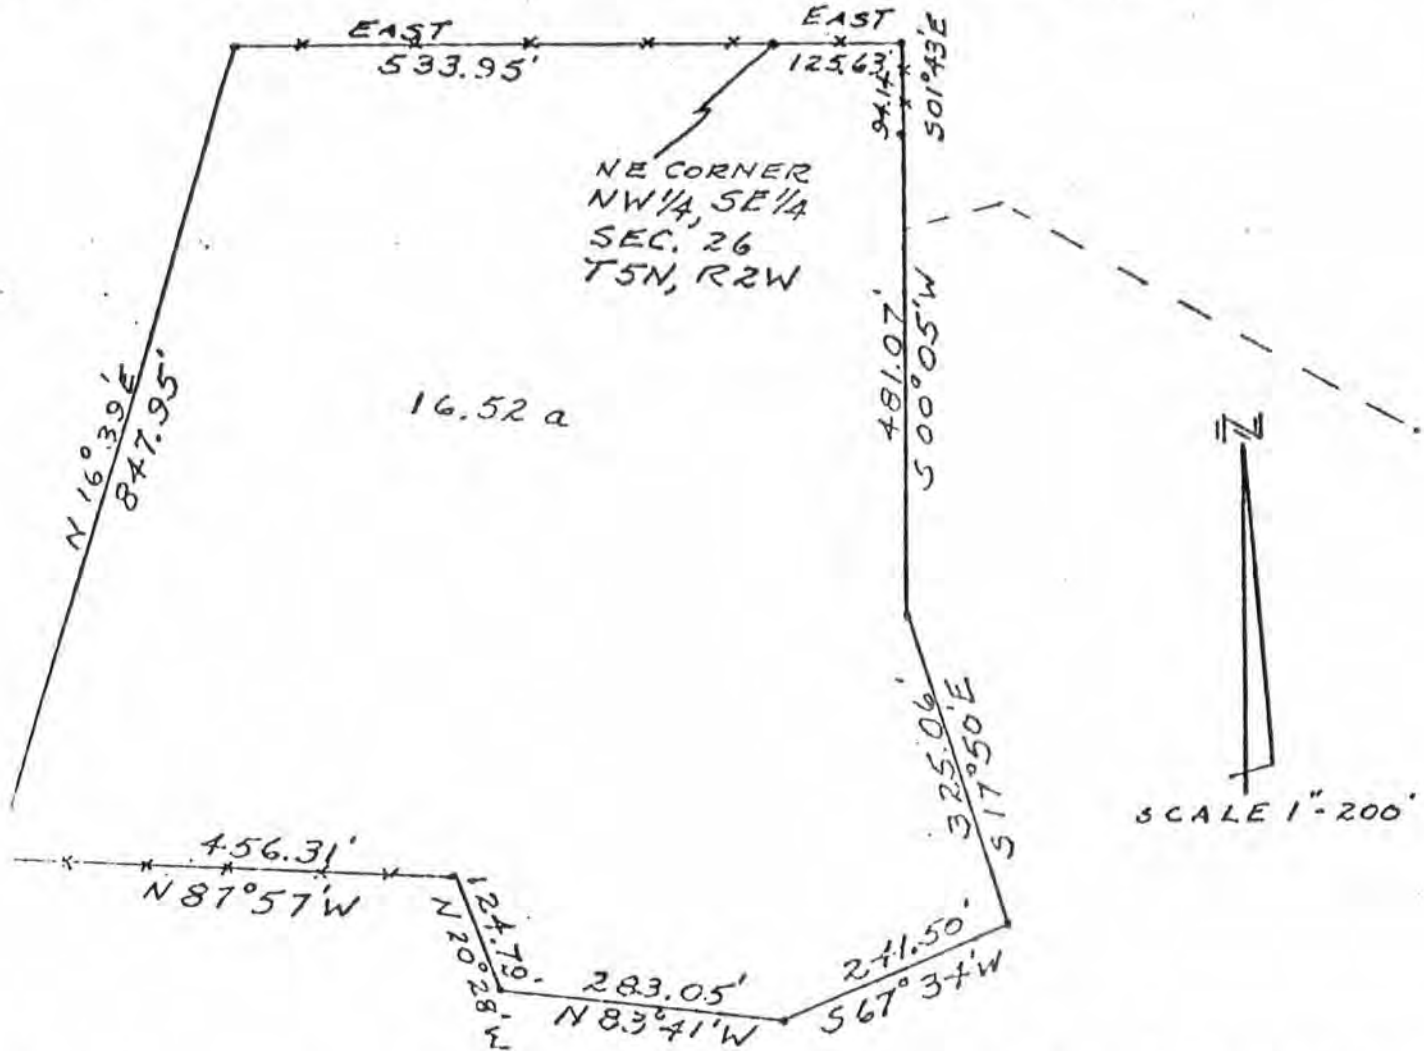

I, D.C. Dixon, registered surveyor, hereby certify that I surveyed the above described land and that the above plat is a correct representation thereof.


D.C. Dixon S-304
D.C. Dixon



HOWARD LUDELL ROAD EASEMENT

1978 JUL 2

A strip of land 16.50 ft. wide along the following described centerline:
 Commencing at the NE corner of the NW $\frac{1}{4}$ of the SE $\frac{1}{4}$ of Sec. 26, T5N, R2W, 4th P.M. Grant County, Wisconsin; thence East, 125.63 ft.; thence S 01°43'E, 94.14 ft.; thence S 00°05'W, 95.00 ft.; to the point of beginning of said easement; thence N 75°10'E, 95.85 ft.; thence S 61°30'E, 475.20 ft.; thence S 70°21'E, 658.35 ft.; thence S 78°40'E, 145.25 ft.; thence S 60°13'E, 648.85 ft.; thence S 32°52'E, 633.60 ft.; thence S 24°00'E, 247.56 ft.; thence S 07°10'E, 108.90 ft.; thence S 05°50'W, 336.60 ft.; thence S 50°45'E, 56.10 ft. to the North right of way line of the township road, the end of said easement.

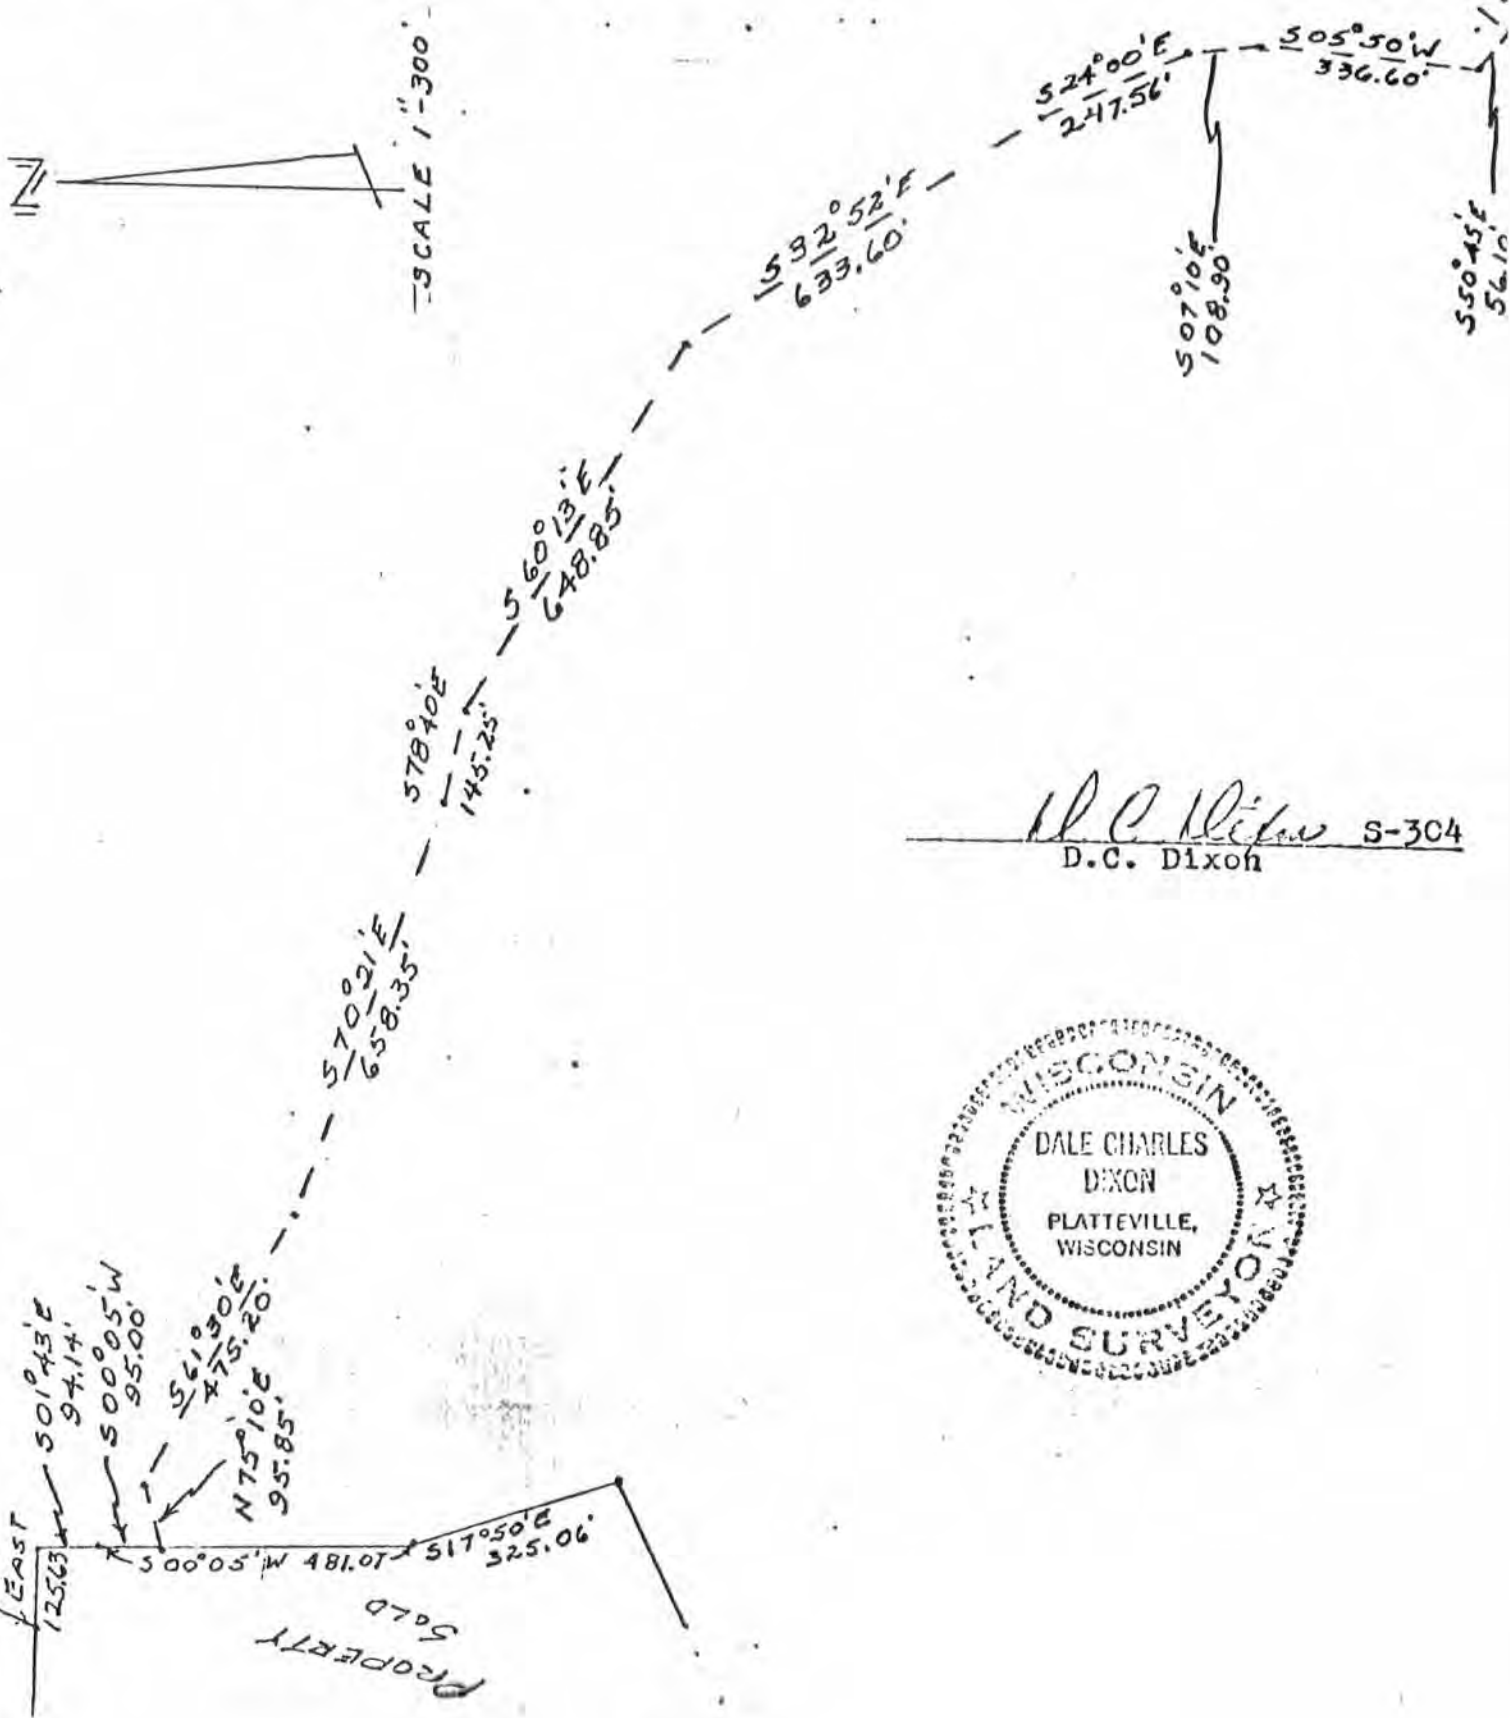

D.C. Dixon S-304
 D.C. Dixon



SEC. 26, T5N, R2W

PROPERTY SOLD