


ENLOE SURVEY

CENTER OF SEC. 34, T 5 N, R 3 W.
OF THE 4TH P.M., GRANT CO., WIS.

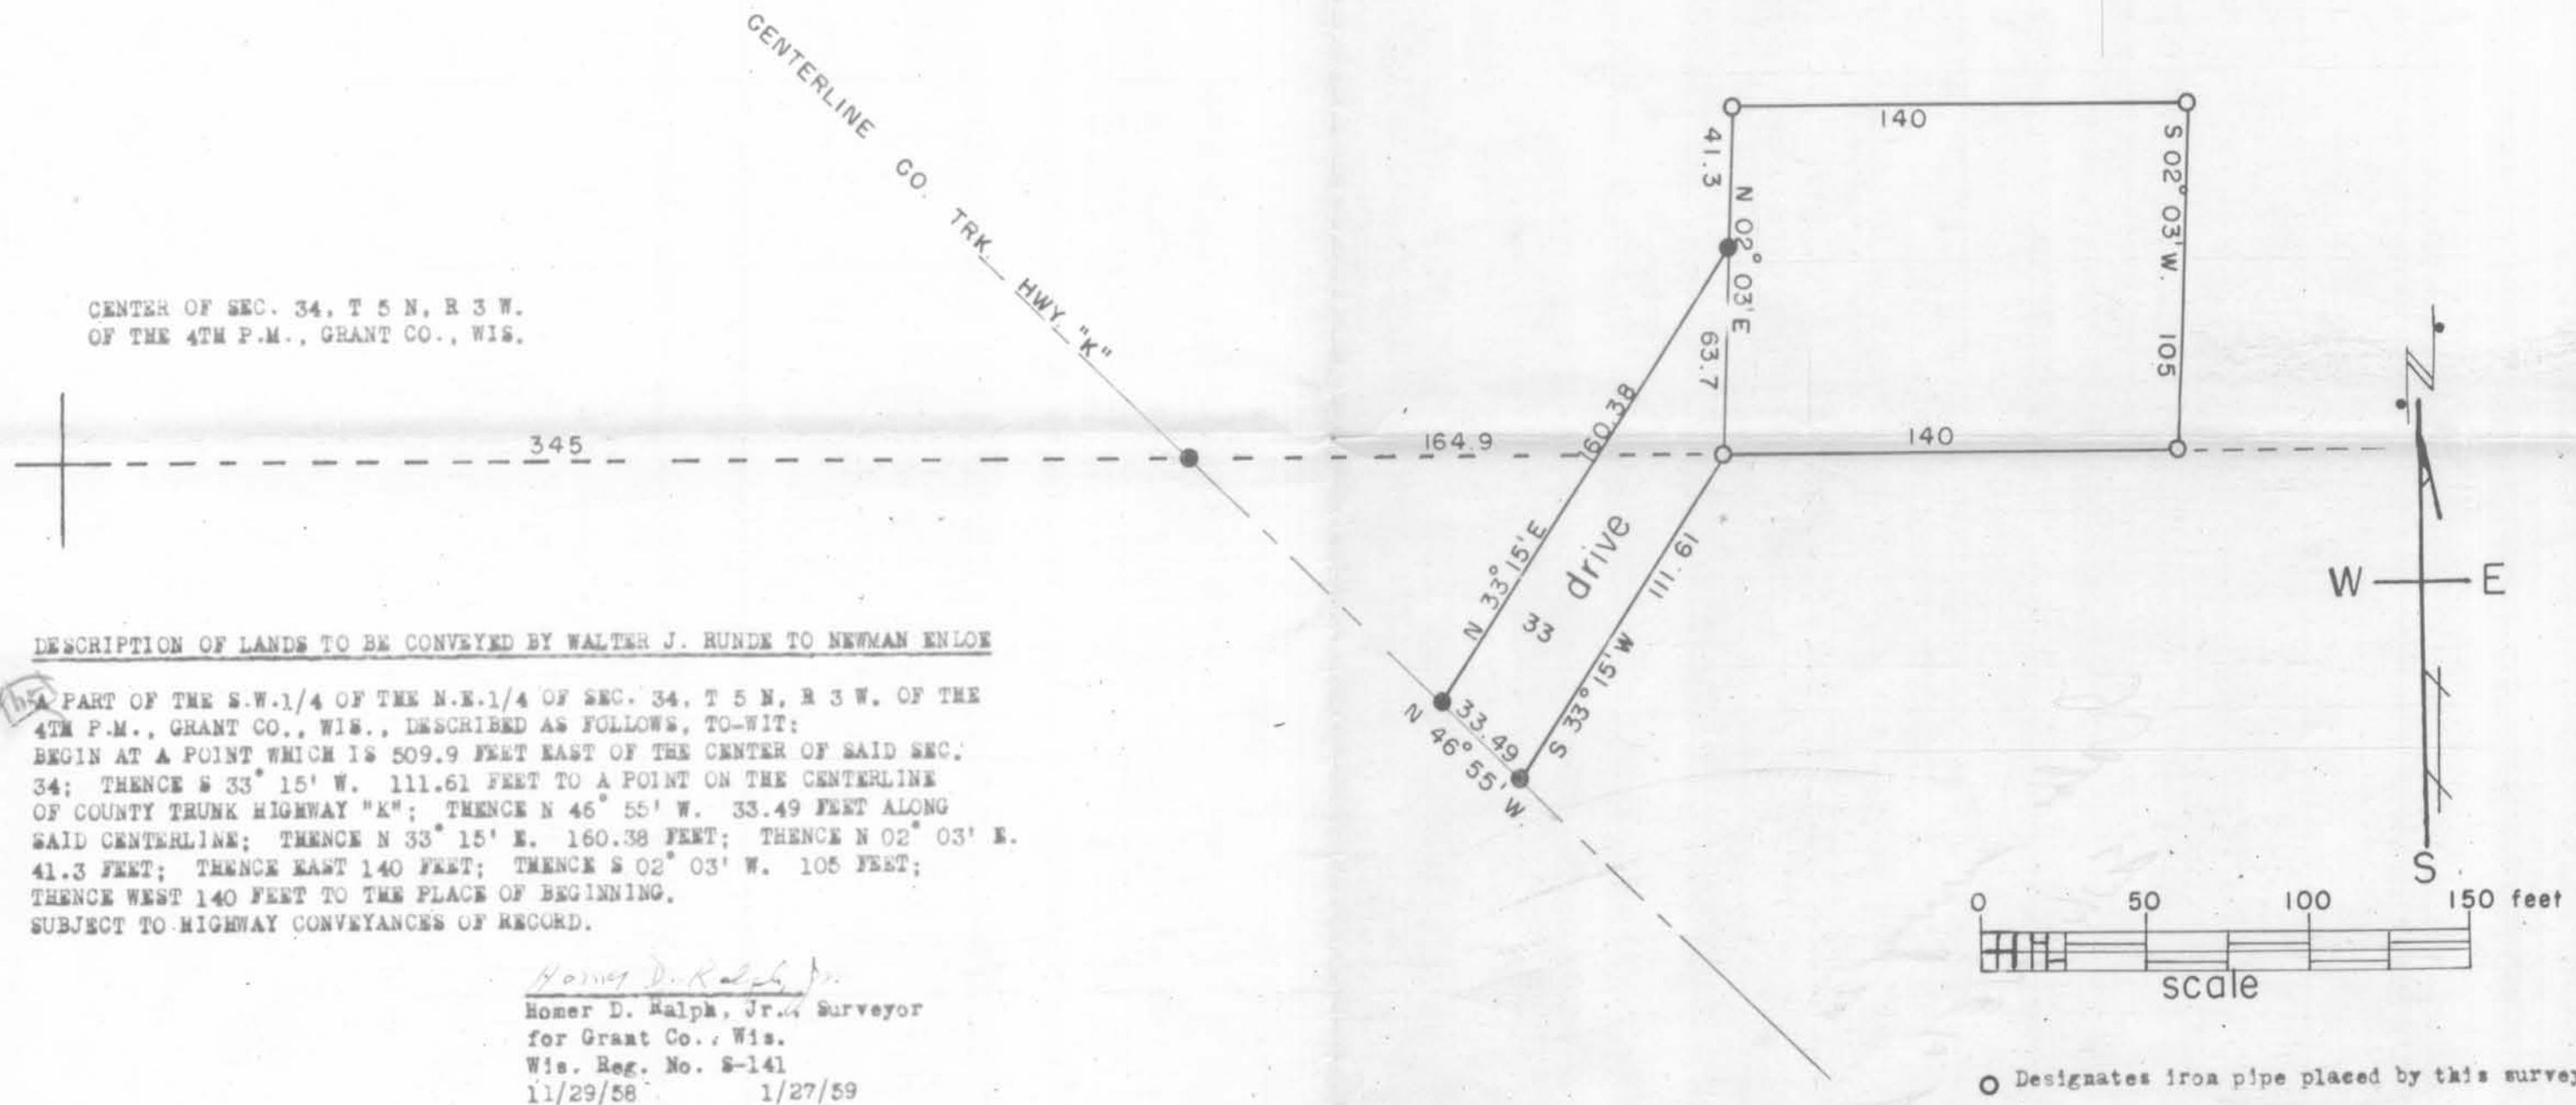

DESCRIPTION OF LANDS TO BE CONVEYED BY WALTER J. RUNDE TO NEWMAN ENLOE

~~THE~~ PART OF THE S.W.1/4 OF THE N.E.1/4 OF SEC. 34, T 5 N, R 3 W. OF THE 4TH P.M., GRANT CO., WIS., DESCRIBED AS FOLLOWS, TO-WIT:
 BEGIN AT A POINT WHICH IS 509.9 FEET EAST OF THE CENTER OF SAID SEC. 34; THENCE S 33° 15' W. 111.61 FEET TO A POINT ON THE CENTERLINE OF COUNTY TRUNK HIGHWAY "K"; THENCE N 46° 55' W. 33.49 FEET ALONG SAID CENTERLINE; THENCE N 33° 15' E. 160.38 FEET; THENCE N 02° 03' E. 41.3 FEET; THENCE EAST 140 FEET; THENCE S 02° 03' W. 105 FEET; THENCE WEST 140 FEET TO THE PLACE OF BEGINNING.
 SUBJECT TO HIGHWAY CONVEYANCES OF RECORD.

Homer D. Ralph, Jr.
 Homer D. Ralph, Jr., Surveyor
 for Grant Co., Wis.
 Wis. Reg. No. S-141
 11/29/58 1/27/59

○ Designates iron pipe placed by this survey.