


RICHARD LOBERGER PROPERTY  
PLATTEVILLE TOWNSHIP  
GRANT COUNTY  
WISCONSIN  
4/3/72

DESCRIPTION:

Commencing at the SW corner of the N $\frac{1}{2}$  of the SE $\frac{1}{4}$  of the SE $\frac{1}{4}$  of Sec. 30, T3N, RLW, 4th P.M. Grant County, Wisconsin; thence East, 884.85 ft.; thence N 12° 26' E, 212.99 ft.; thence West, 930.71 ft.; thence South, 208.00 ft. to the point of beginning, containing 4.33 acres more or less.

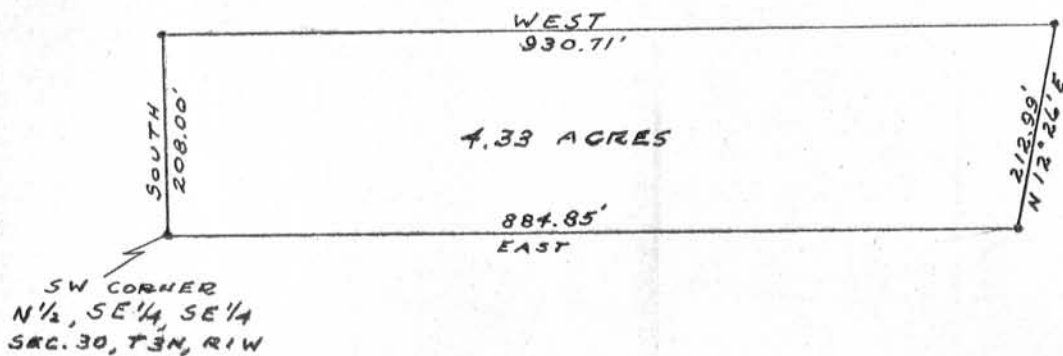

LEGEND  
• 1" X 2" IRON PIPE

