
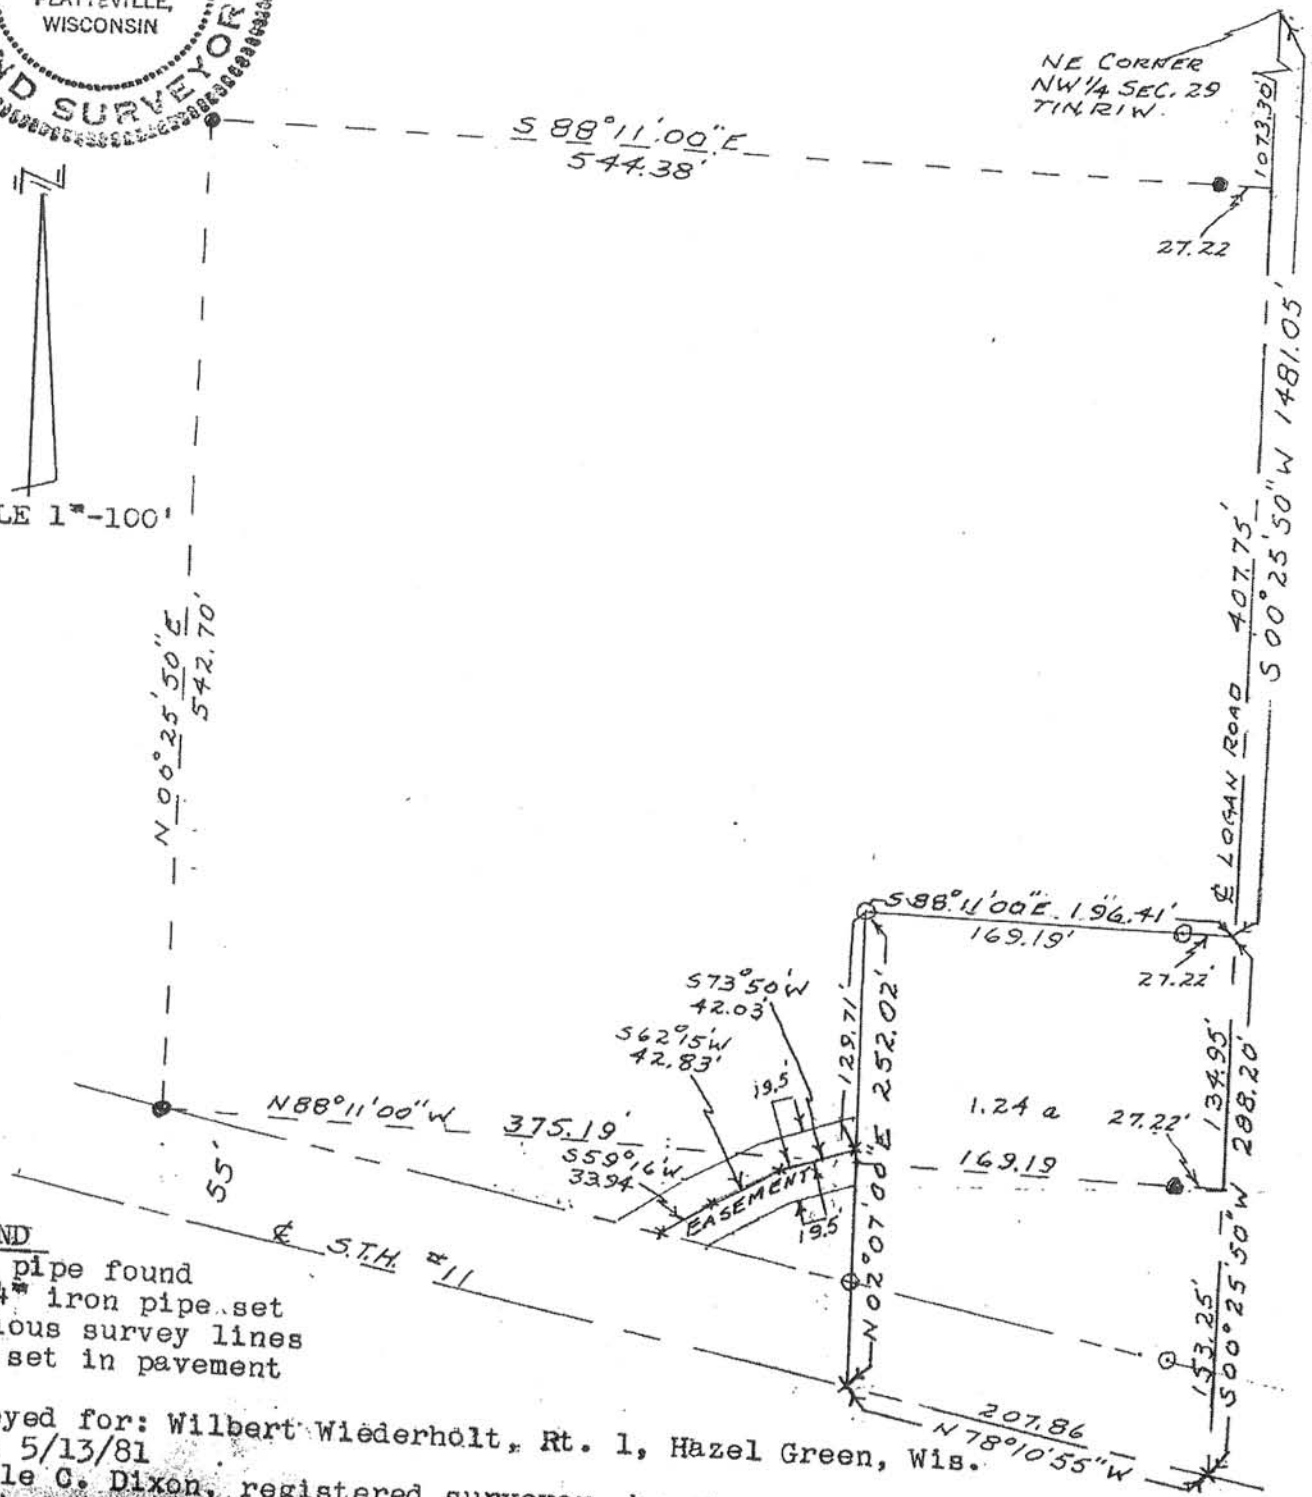


WILBERT WIEDERHOLT SURVEY
 HAZEL GREEN TOWNSHIP
 GRANT COUNTY, WIS.
 5/13/81

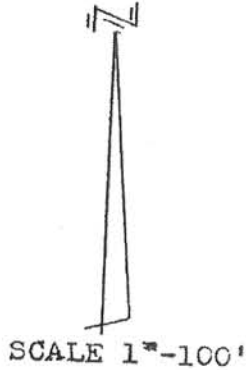

LEGEND

- Iron pipe found
- ⊙ 1" x 24" iron pipe set
- - - Previous survey lines
- x Nail set in pavement

Surveyed for: Wilbert Wiederholt, Rt. 1, Hazel Green, Wis.
 Date: 5/13/81
 I, Dale C. Dixon, registered surveyor, hereby certify that I surveyed the above land and that the survey is correct to the best of my knowledge and belief.

Dale C. Dixon S-304
 Dale C. Dixon

FILE