
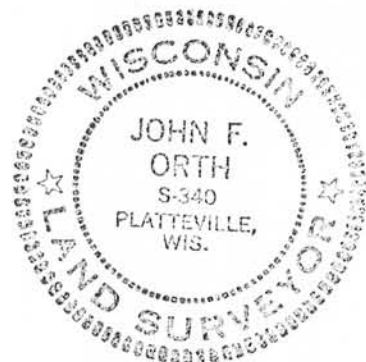


Trailer Park

Beginning at the S.E. Corner of Block 1-E of Lower Hazel Green, in the Village of Hazel Green, Wisconsin; thence N. 79° 44' E. 175.80 ft.; thence S. 14° 41' E. 200.00 ft.; thence S. 84° 12' W. 206.93 ft.; thence N. 15° 38' W. 184.10 ft.; thence N. 79° 44' E. 32.30 ft. to the point of beginning.

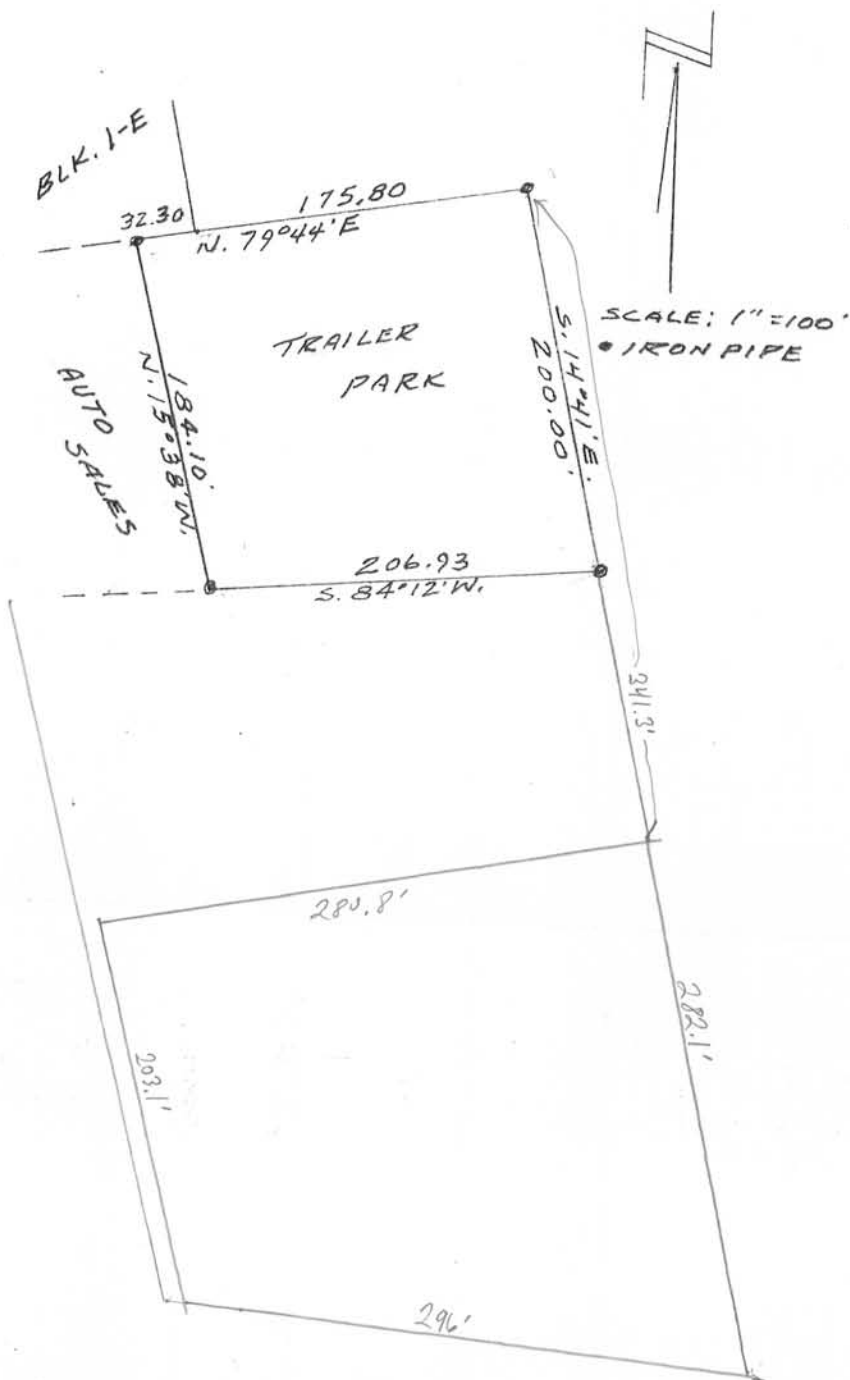

341.3
 282.1
 623.4

341.3
 282.1
 623.4