

Richard S. Osborn, P.E. R.L.S.


217 Maureen Avenue
Dickeyville, Wisconsin 53808
(608) 568-7995

September 11, 1977

VERNE DAVIS SURVEY

LEGEND
SCALE 1"=100'
1" IRON PIPE SET = •
----- EXISTING ROAD

SURVEY ORDERED BY:
VERNE DAVIS
SURVEYED: 9-12-77

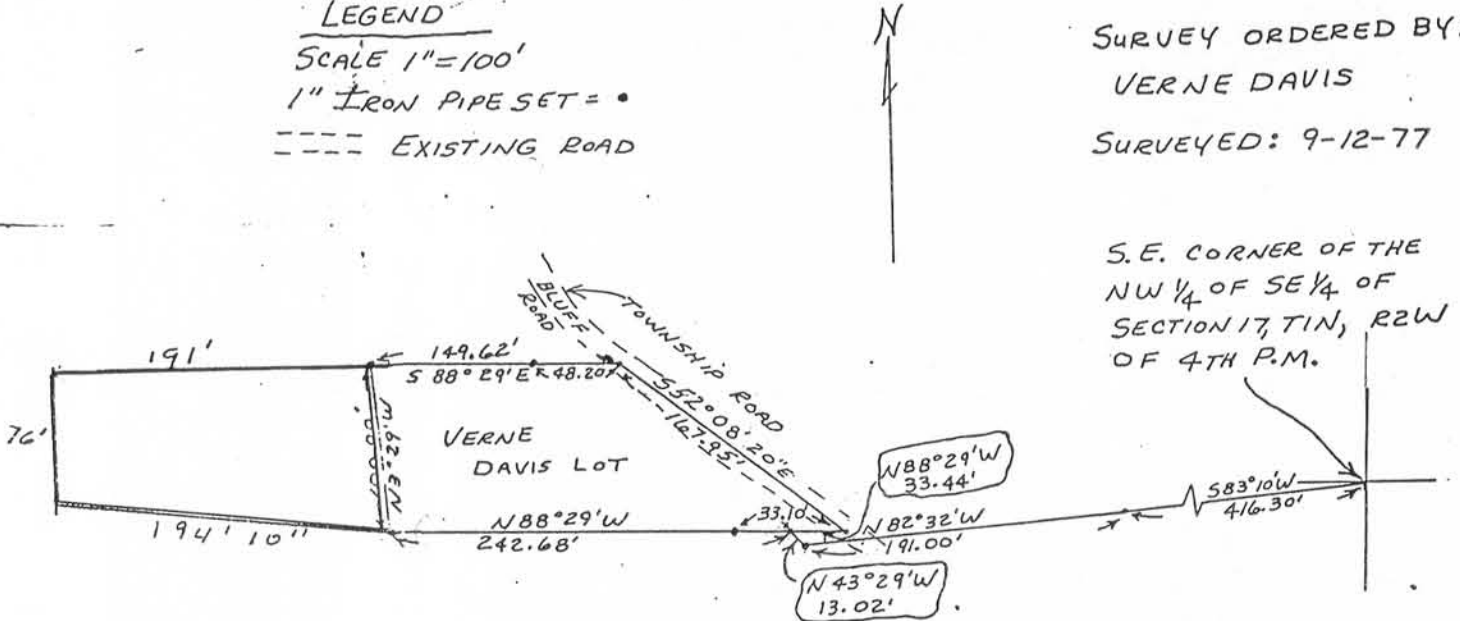

Commencing at the Southeast Corner of the Northwest $\frac{1}{4}$ of the Southeast $\frac{1}{4}$ of Section 17, Township 1 North, Range 2 West of the Fourth Principle Meridian; being in Jamestown Township, Grant County Wisconsin;

Thence South $83^{\circ}10'$ West 416.30 feet;
Thence North $82^{\circ}32'$ West 191.00 feet;
Thence North $43^{\circ}29'$ West 13.02 feet to the
Point of Beginning;
Thence North $88^{\circ}29'$ West 242.68 feet;
Thence North $3^{\circ}29'$ West 100.00 feet;
Thence South $88^{\circ}29'$ East 149.62 feet;
Thence South $52^{\circ}08'20''$ East 167.95 feet;
Thence North $88^{\circ}29'$ West 33.44 feet;

to the Point of Beginning; containing 0.487 acres, more or less.

I, Richard S. Osborn, Registered Surveyor, hereby certify that I have surveyed the above described tract of land and that the above plat is correct and true representation of the land surveyed.

Date 9-14-77

Richard Scott Osborn

Richard Scott Osborn
R.L.S. 1233



Rec. Sep 16 1985 at 8:30 A.M.