

Sheet #1


COUNTY OF GRANT WISCONSIN

Surveyed Sept. 11 & 25 1940
Isidore Muller
R.W. Kieler
John T. Buser
County Surveyor

Lancaster, Wis.

OFFICE OF
JOHN T. BUSER
SURVEYOR
PLATTEVILLE, WIS.

See sheet No. 2
for enlarged plan

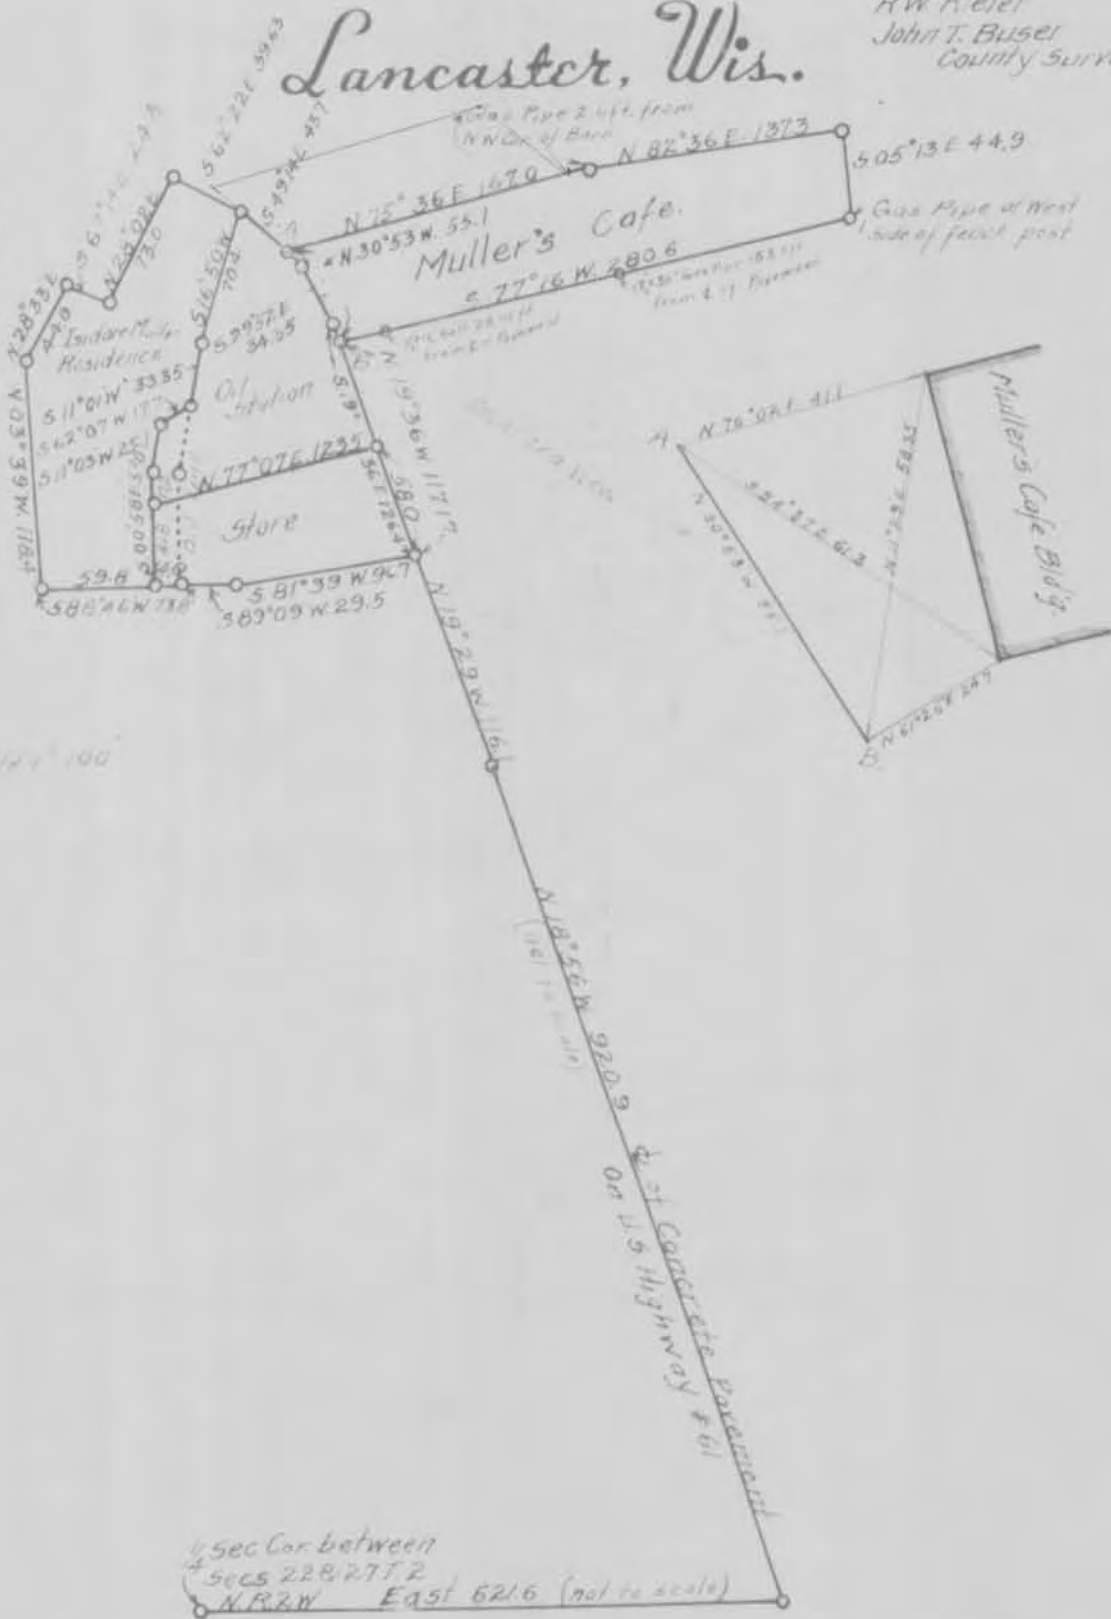

52424° 100'

