


5-115

GERALD J. LEIFKER PROPERTY  
ANN STREET  
DICKEYVILLE, WISCONSIN

DESCRIPTION: A tract of land which is a part of the SE $\frac{1}{4}$  of the SW $\frac{1}{4}$  of Sec. 22, T2N. R2W, of the 4th P.M. in the Village of Dickeyville, Grant County, Wisconsin, described as follows, to wit; Begin at a point which is North, 156.24 ft. and N 89°39'W, 358.60 ft. from the SE corner of said SE $\frac{1}{4}$  of the SW $\frac{1}{4}$ ; thence N 89°39'W, 80 ft.; thence North 96.77 ft.; thence S 89°35'E, 80 ft.; thence South, 96.68 ft. to the place of beginning.

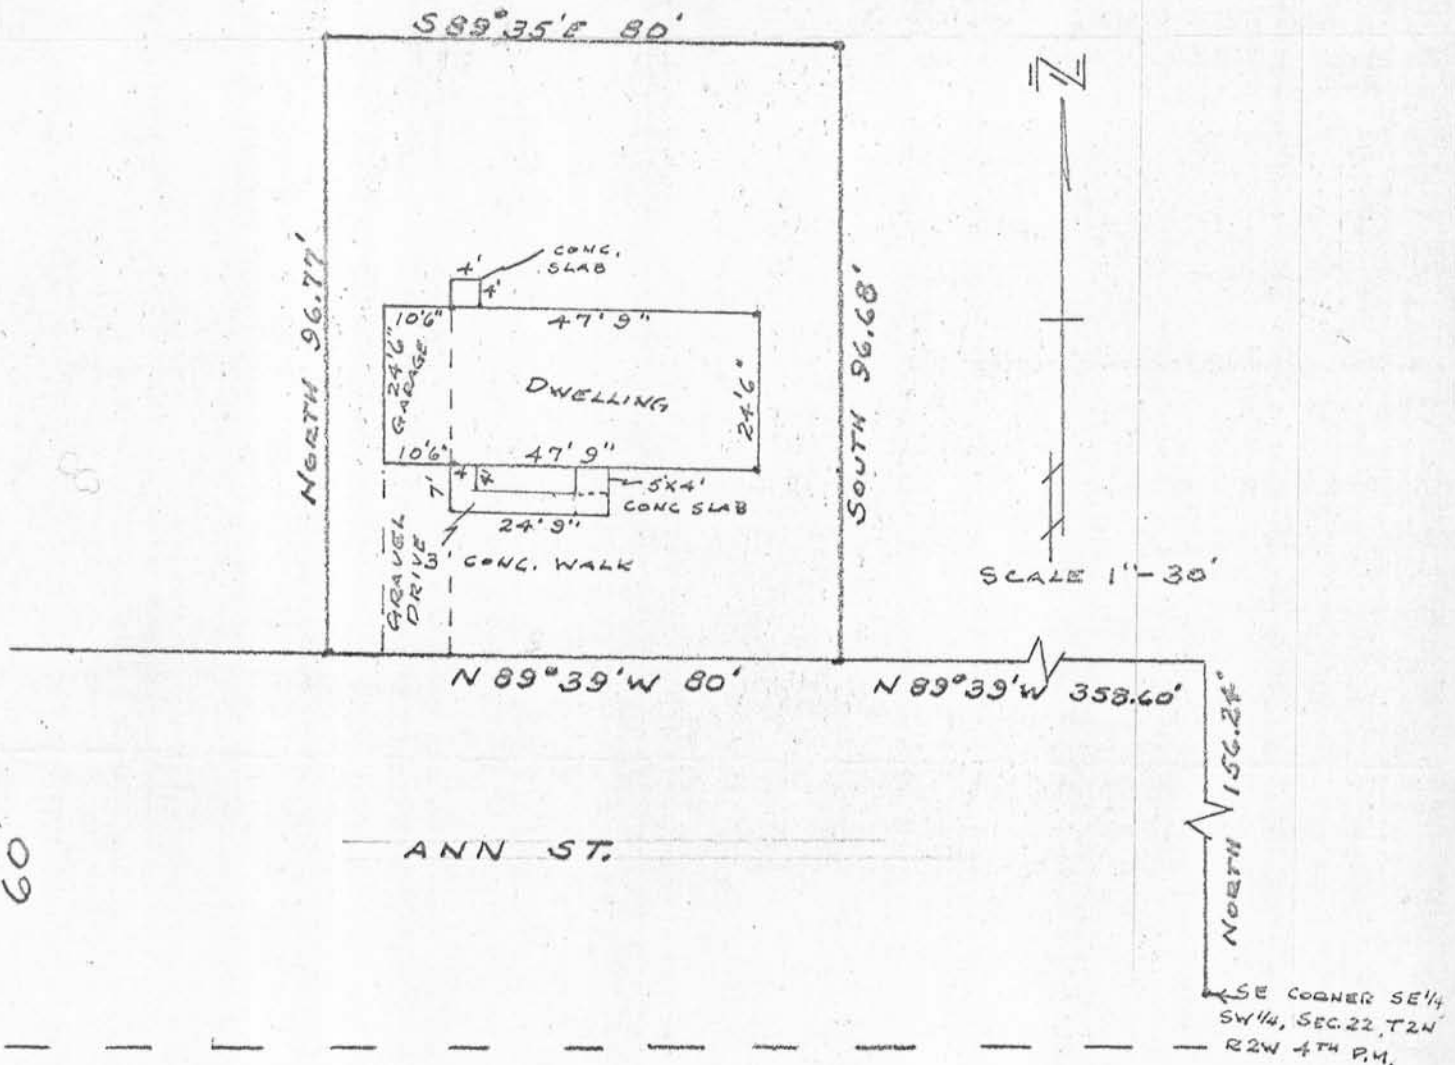

I hereby certify that I surveyed the above described property and that the above plat is an accurate survey and a true representation thereof and correctly shows the exterior boundary lines and location of buildings and other improvements on said property and correct measurements thereof.

*H. C. Dixon*  
D.C. Dixon, Registered Surveyor

S-304

10/25/65 H.C.D.