


OFFICE OF
JOHN T. BUSER
 GRANT COUNTY SURVEYOR

PLATTEVILLE, WIS.

Surveyed Sept 2 & 4 - 1947
 Howard L. Speigel
 Clayton Henning
 John T. Buser
 County Surveyor.

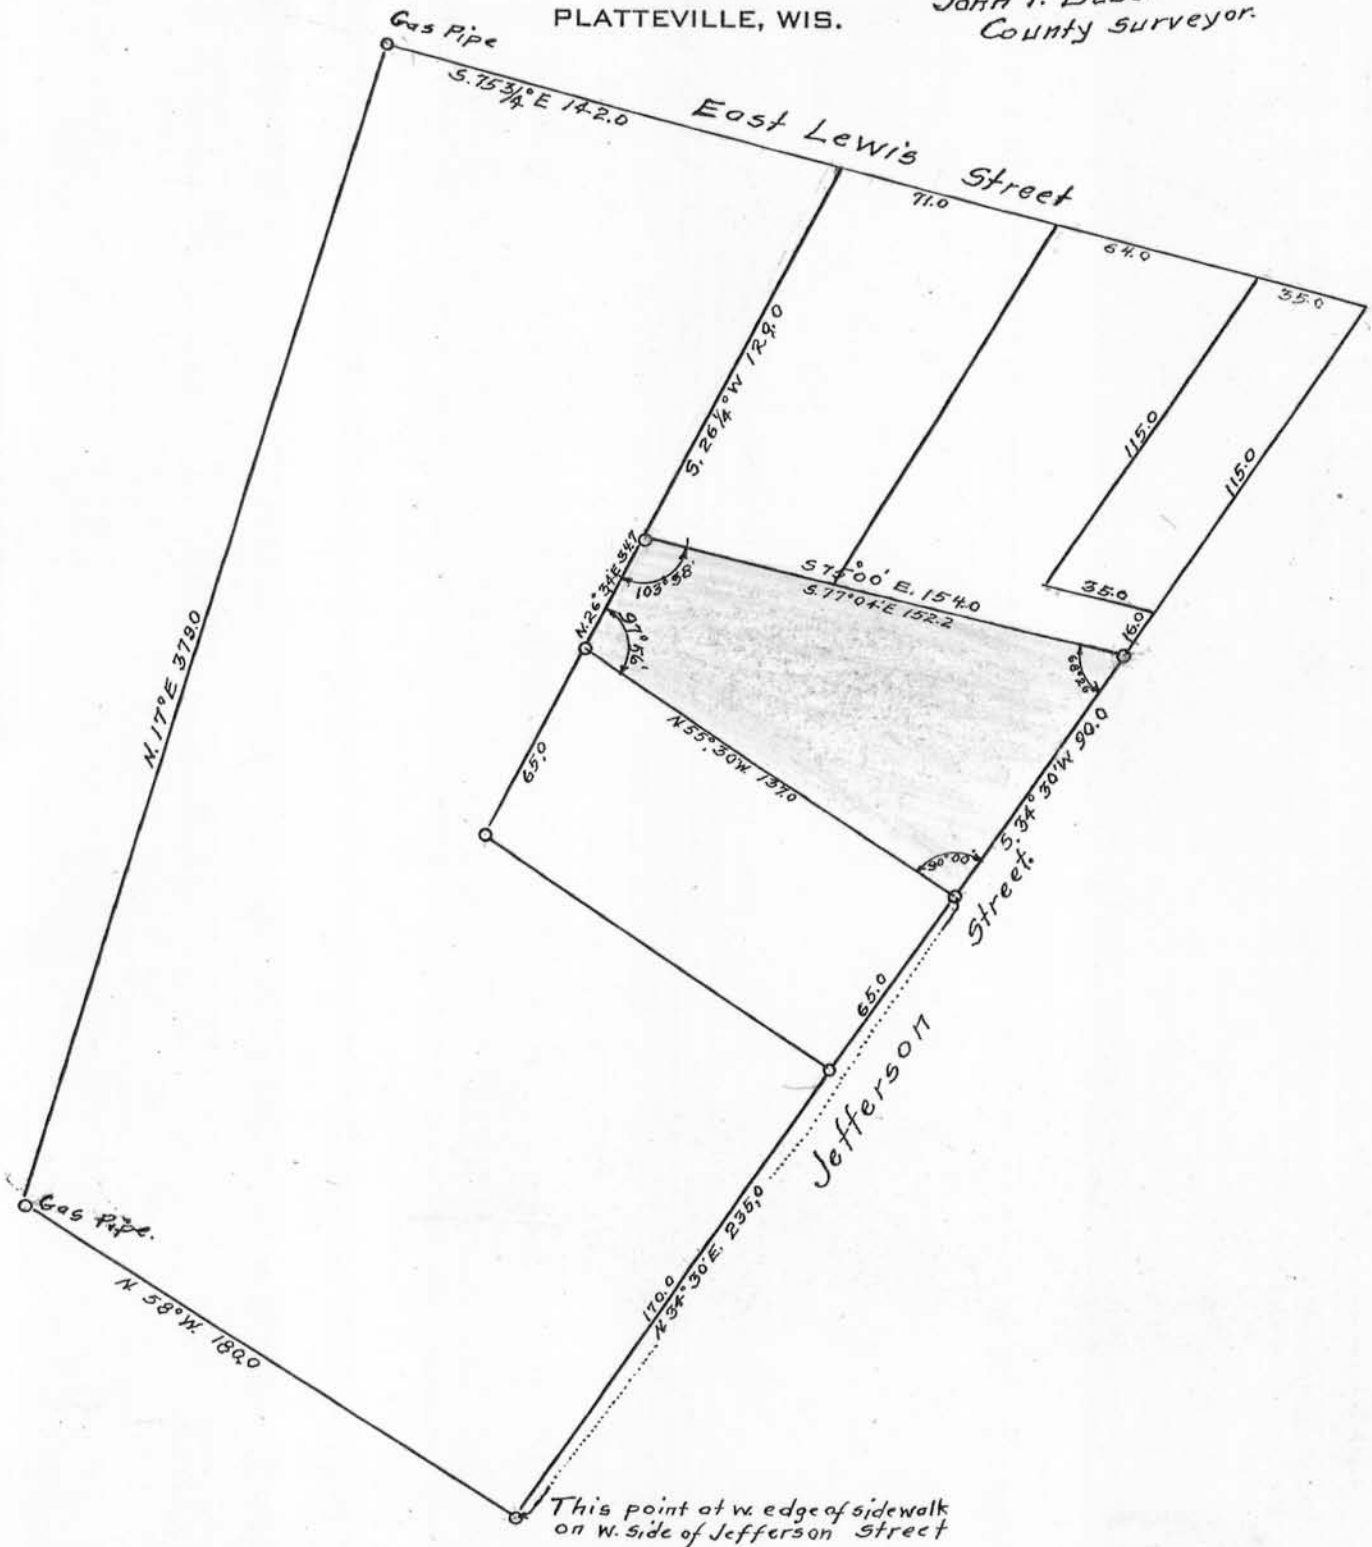

Figures in Red are from a former survey made by Henry Klienhammer.