
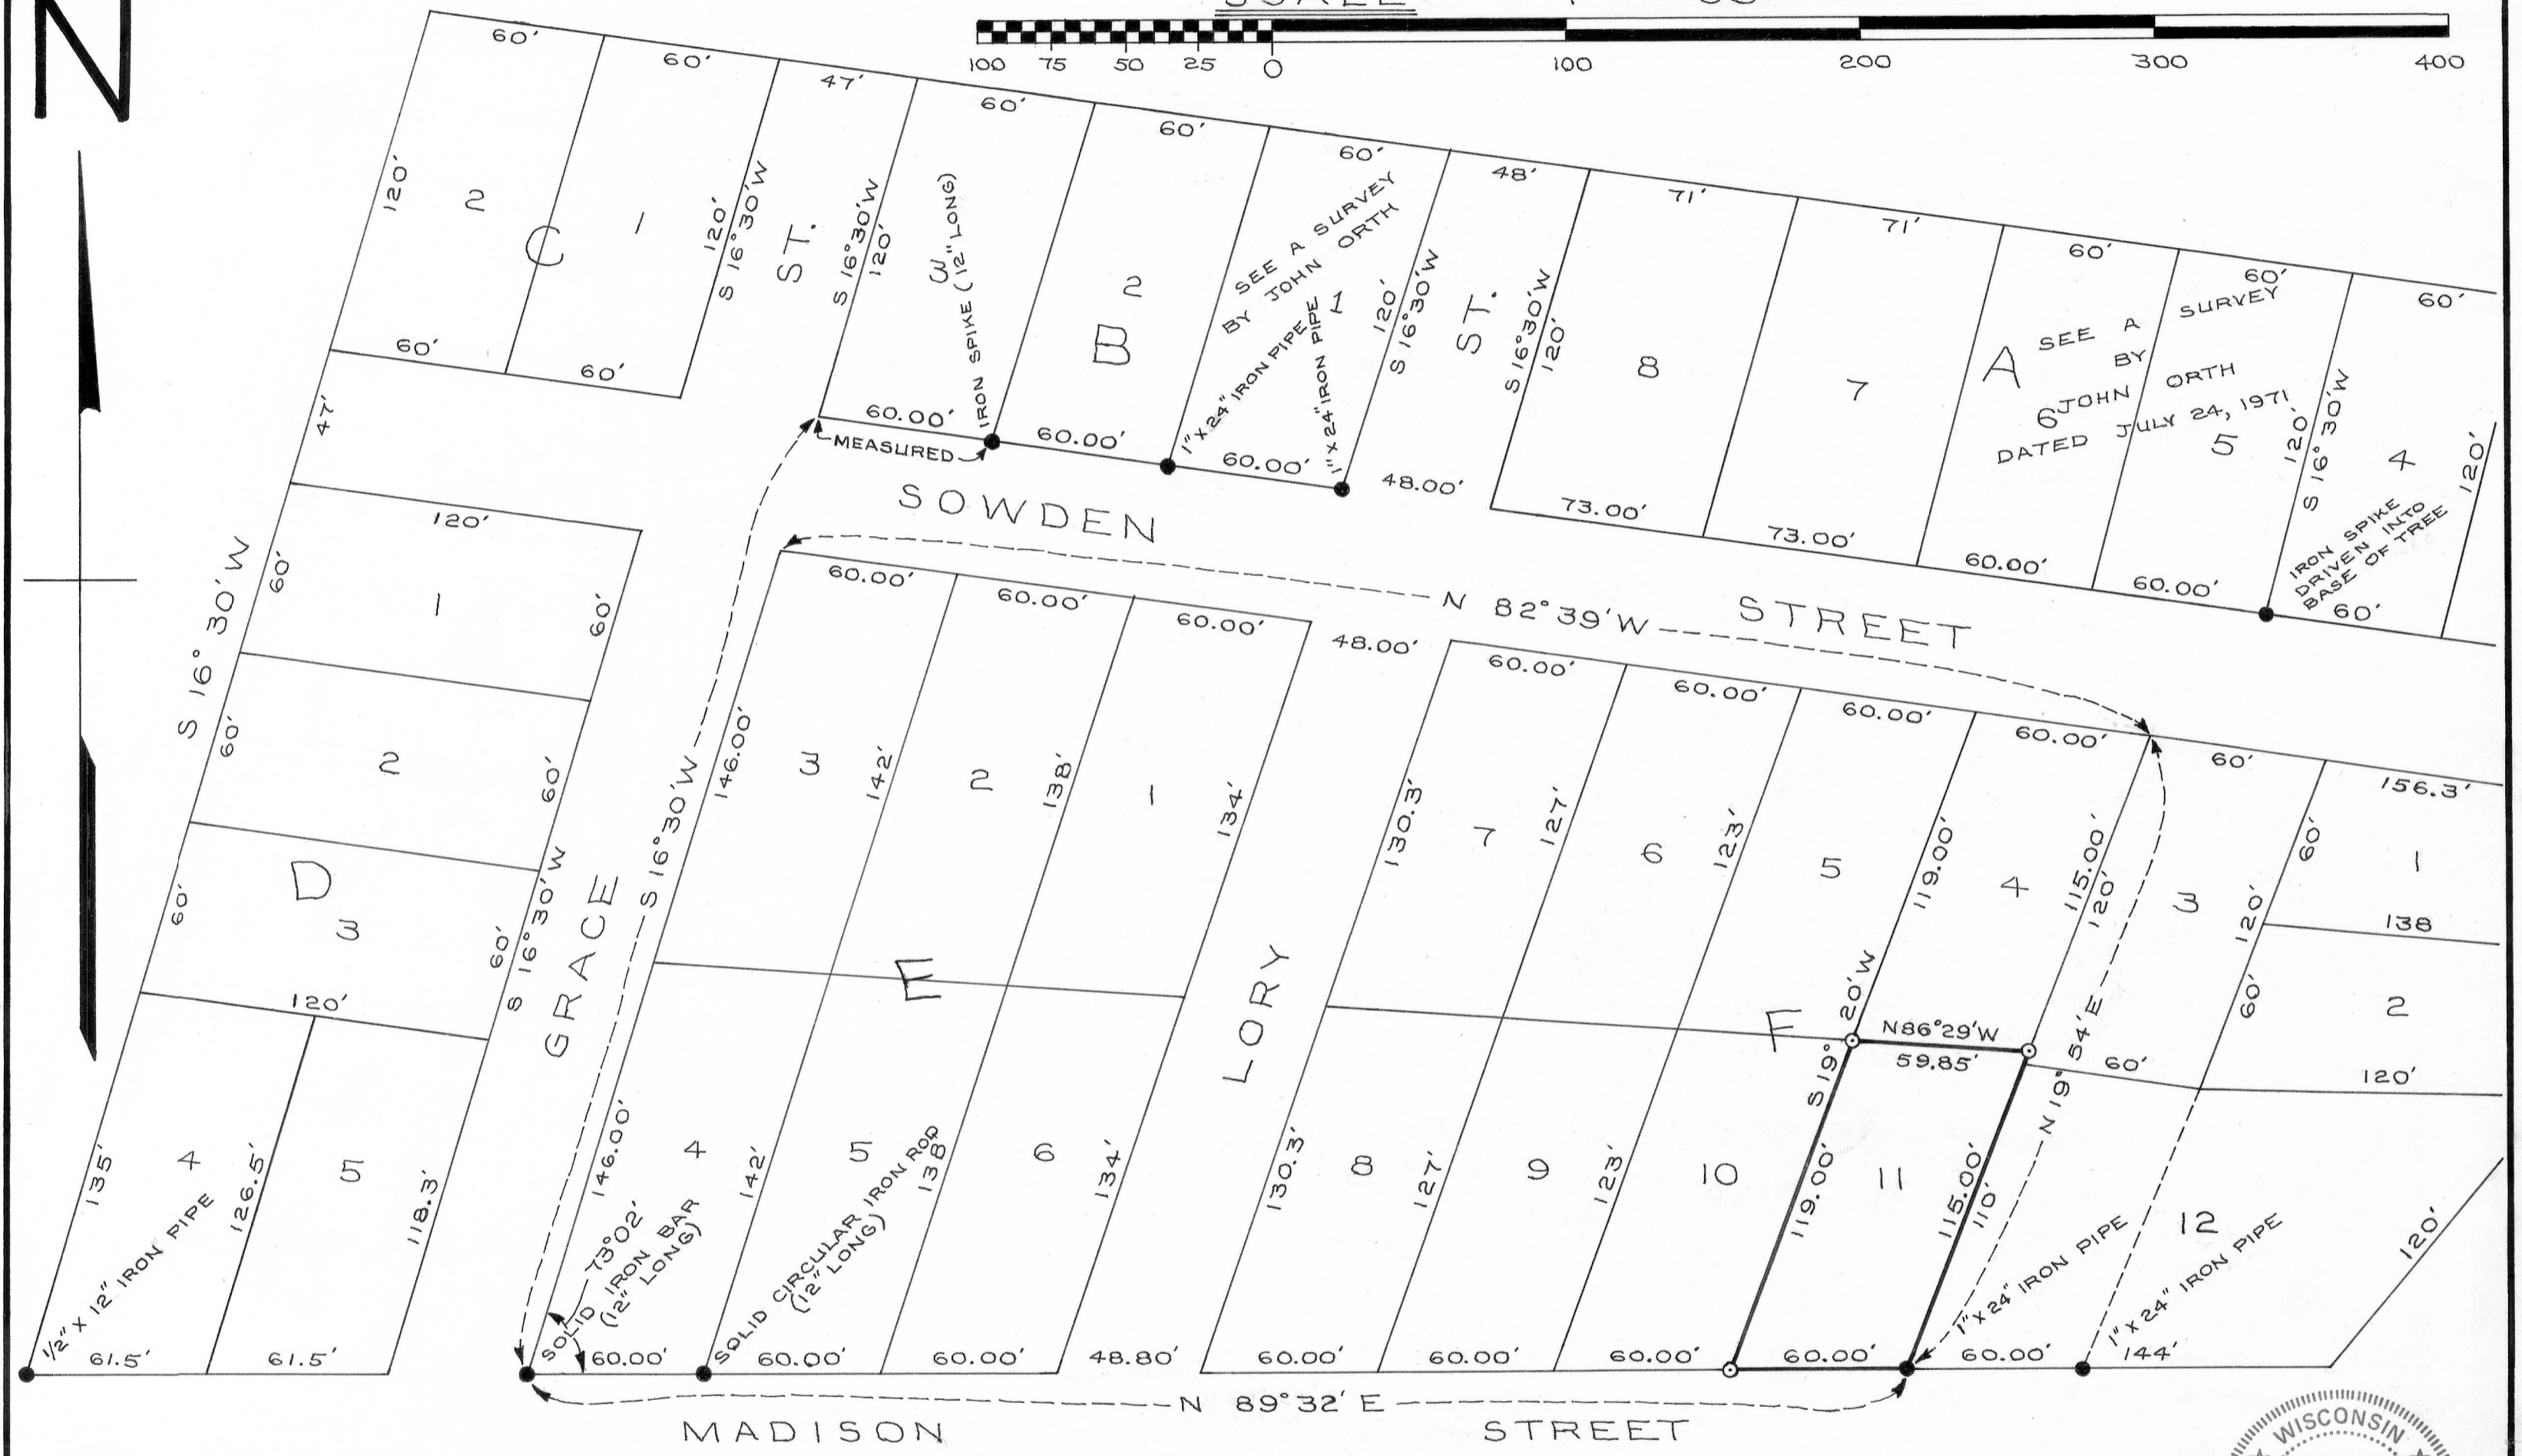
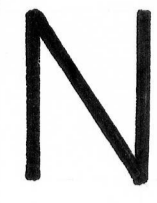


LOUIS J. KNETTER SURVEY

SCALE: 1" = 50'

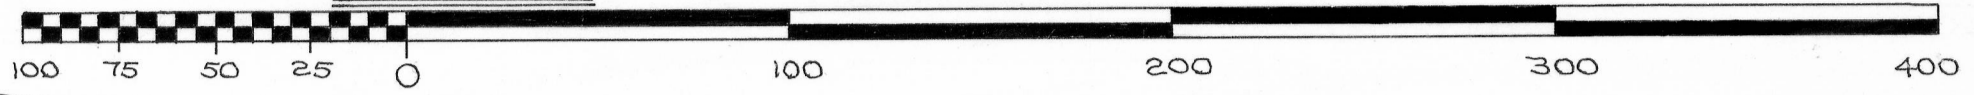

LEGEND:


- 1" x 24" IRON PIPE PLACED BY THIS SURVEY
- ALL OTHER MARKERS FOUND ARE NOTED ON THE ABOVE PLAT

DESCRIPTION:

LOT 11, OF BLOCK "F", OF BUNT'S ADDITION TO THE CITY OF PLATTEVILLE, GRANT COUNTY, WISCONSIN, ACCORDING TO THE RECORDED MAP OR PLAT THEREOF.

NOTE:

THE PLAT OF BUNT'S ADDITION SAYS "IRON STAKES 12 INCHES LONG WERE DRIVEN IN THE GROUND AT ALL LOT AND BLOCK CORNERS". (PLAT RECORDED MAY 21, 1906)

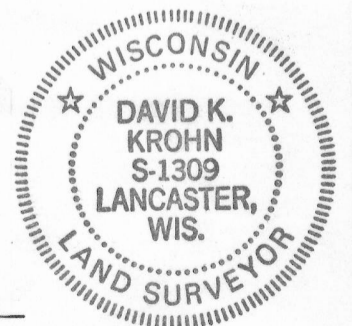

David K. Krohn

DAVID K. KROHN
REG. NO. 1309
10/20/76 - 10/26/76