

SURVEY FOR: Larry Arneson

January 18, 1980

Sheet 1 of 2

A SURVEY OF A PARCEL OF LAND DESCRIBED AS FOLLOWS:

Commencing at an existing stone monument at the Southwest Corner of the Southeast Quarter (SE $\frac{1}{4}$) of Section 11, T. 8 N., R. 1 W., Grant County, Wisconsin; Thence North, 1676.64 feet; Thence East, 1079.43 feet to a point on the Northerly right-of-way limit of Grant County Trunk Highway "G" and the point of beginning;

Thence N 54°-34'-00" E, 70.83 feet along said right-of-way limit;

Thence N 0°-03'-00" W, 276.04 feet to an existing 1 inch diameter iron pipe;

Thence N 54°-35'-08" E, 193.19 feet to an existing 1 inch diameter iron pipe;

Thence N 0°-03'-00" W, 165.00 feet to a 1 inch diameter iron pipe;

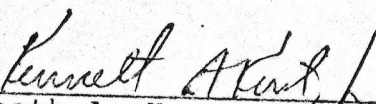
Thence S 54°-35'-08" W, 264.00 feet to a 1 inch diameter iron pipe;

Thence S 0°-03'-00" E, 441.06 feet to the point of beginning;

The above described parcel of land being located in the Northwest Quarter (NW $\frac{1}{4}$) of the Southeast Quarter (SE $\frac{1}{4}$) of Section 11, T. 8 N., R. 1 W., Grant County, Wisconsin and containing 1.18 acres and being subject to all conveyances of record.

I certify that I have surveyed the above described parcel of land and that the following Plat is an accurate survey and a true representation thereof and correctly shows the exterior boundary lines of said parcel and the correct measurements thereof to the best of my knowledge and belief.

Dated this 22nd day
of February, 1980
Richland Center, Wisconsin


Kenneth A. Kerst, Jr.
Registered Land Surveyor S-1385



3648.001

FEB 28 1980

HOVELSRUD CONSULTING ASSOCIATES LTD.

ENGINEERING - LAND SURVEYING - PLANNING
 BUILDINGS - STRUCTURES - SOIL INVESTIGATIONS
 RICHLAND COUNTY BANK BUILDING
 RICHLAND CENTER, WISCONSIN 53581

Survey for: Larry Arneson

January 18, 1980

Sheet 2 of 2

Located in the Northwest Quarter (NW 1/4) of the Southeast Quarter (SE 14) of Section 11, T. 8 N., R. 1 W., Grant County, Wisconsin.

