
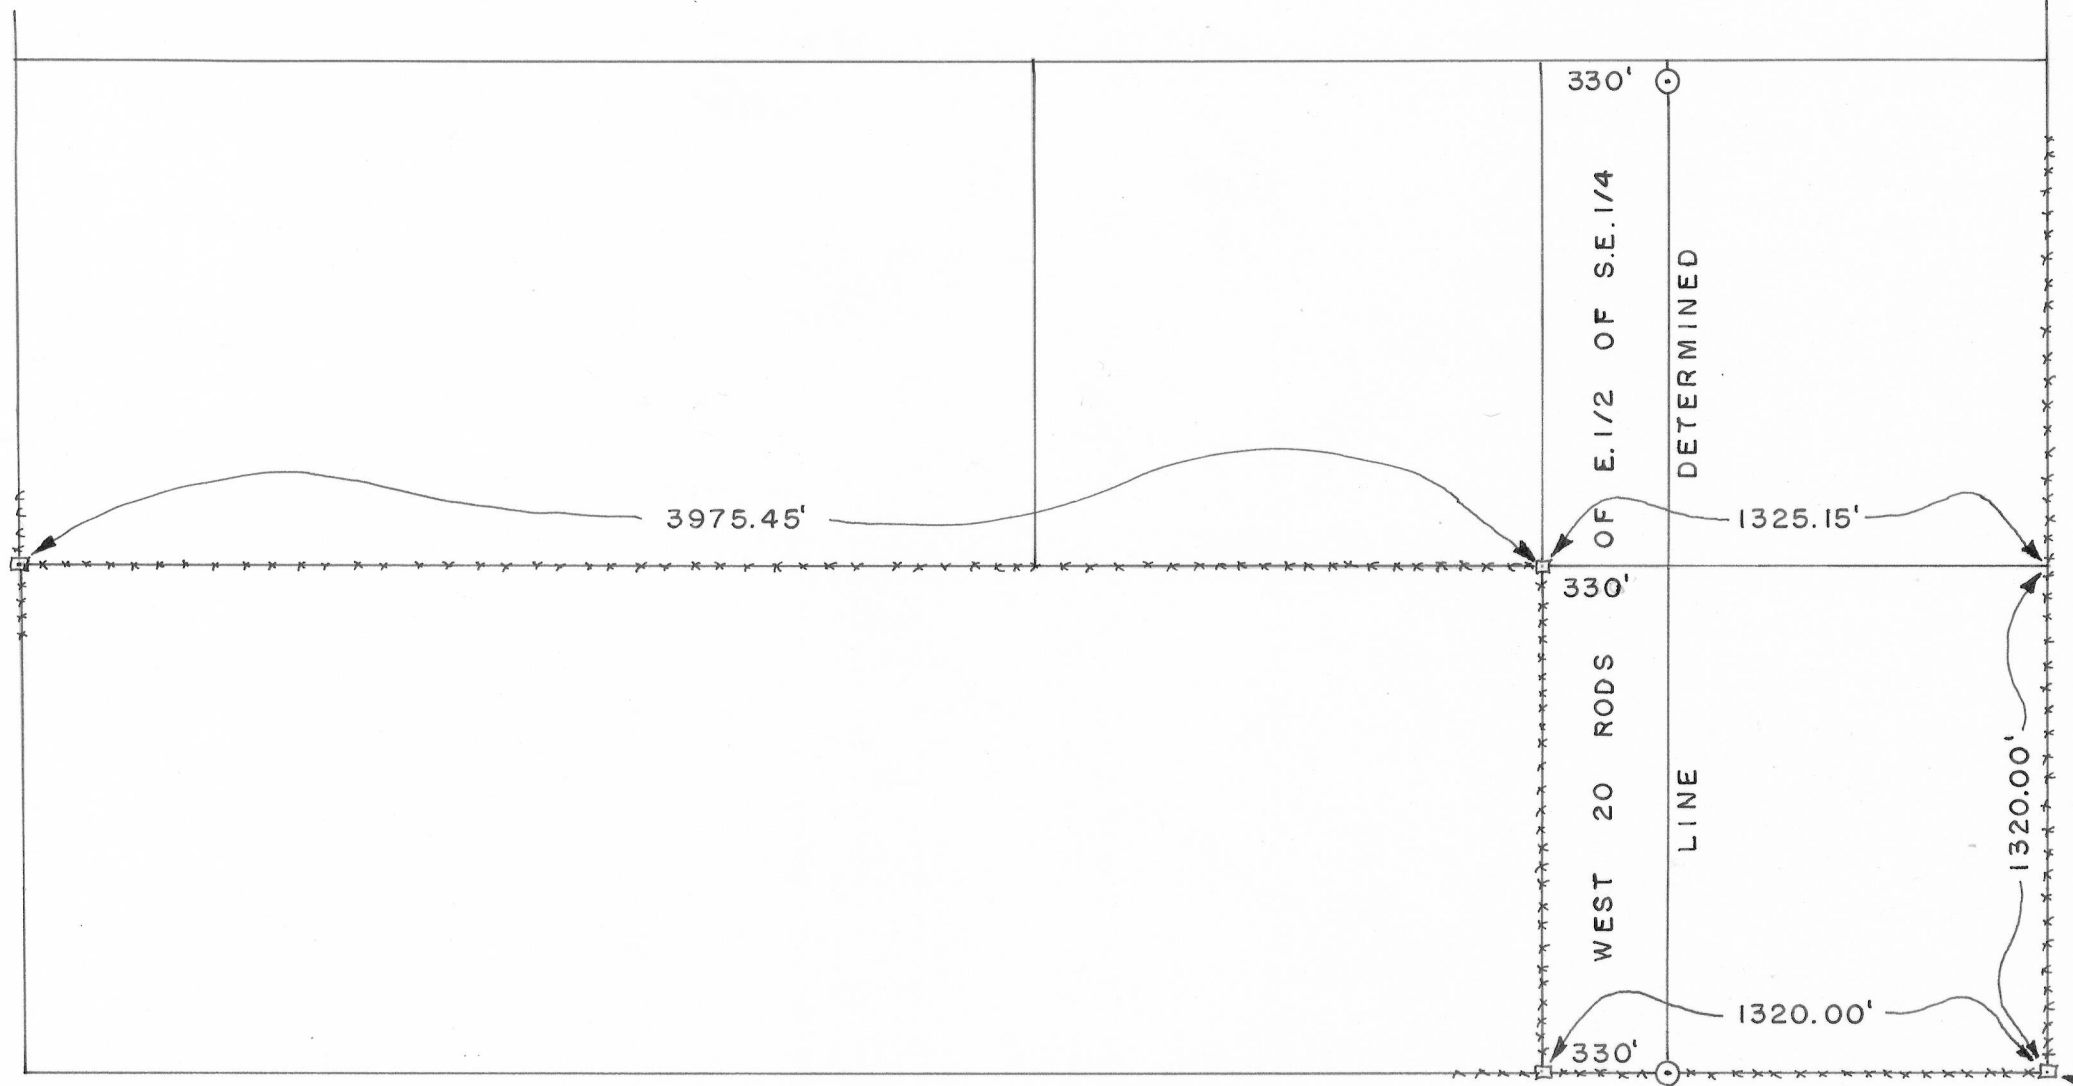



HESSELING — JANSEN FENCE LINE SURVEY

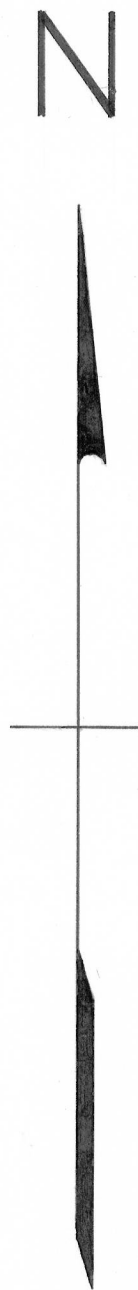

SOUTH 1/2 OF SECTION 2, T 1 N, R 2 W.

LEGEND:

- ⊙ 1" X 24" IRON PIPE PLACED BY THIS SURVEY
- FENCE
- ⊠ CORNER POST
- ALL DISTANCES SHOWN WERE MEASURED AS SUCH

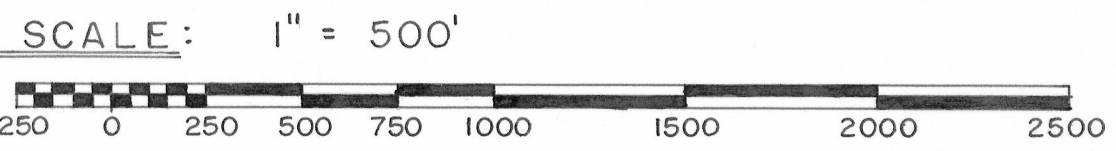

SOUTHEAST CORNER OF SECTION 2, T 1 N, R 2 W, OF THE 4TH P.M., GRANT COUNTY, WISCONSIN.

David K. Krohn
 DAVID K. KROHN
 5/29/75 - 5/31/75



Homer D. Ralph, Jr.
 HOMER D. RALPH, JR.
 SURVEYOR FOR GRANT COUNTY, WISCONSIN.