


N

# FRANCIS BURBACH SURVEY

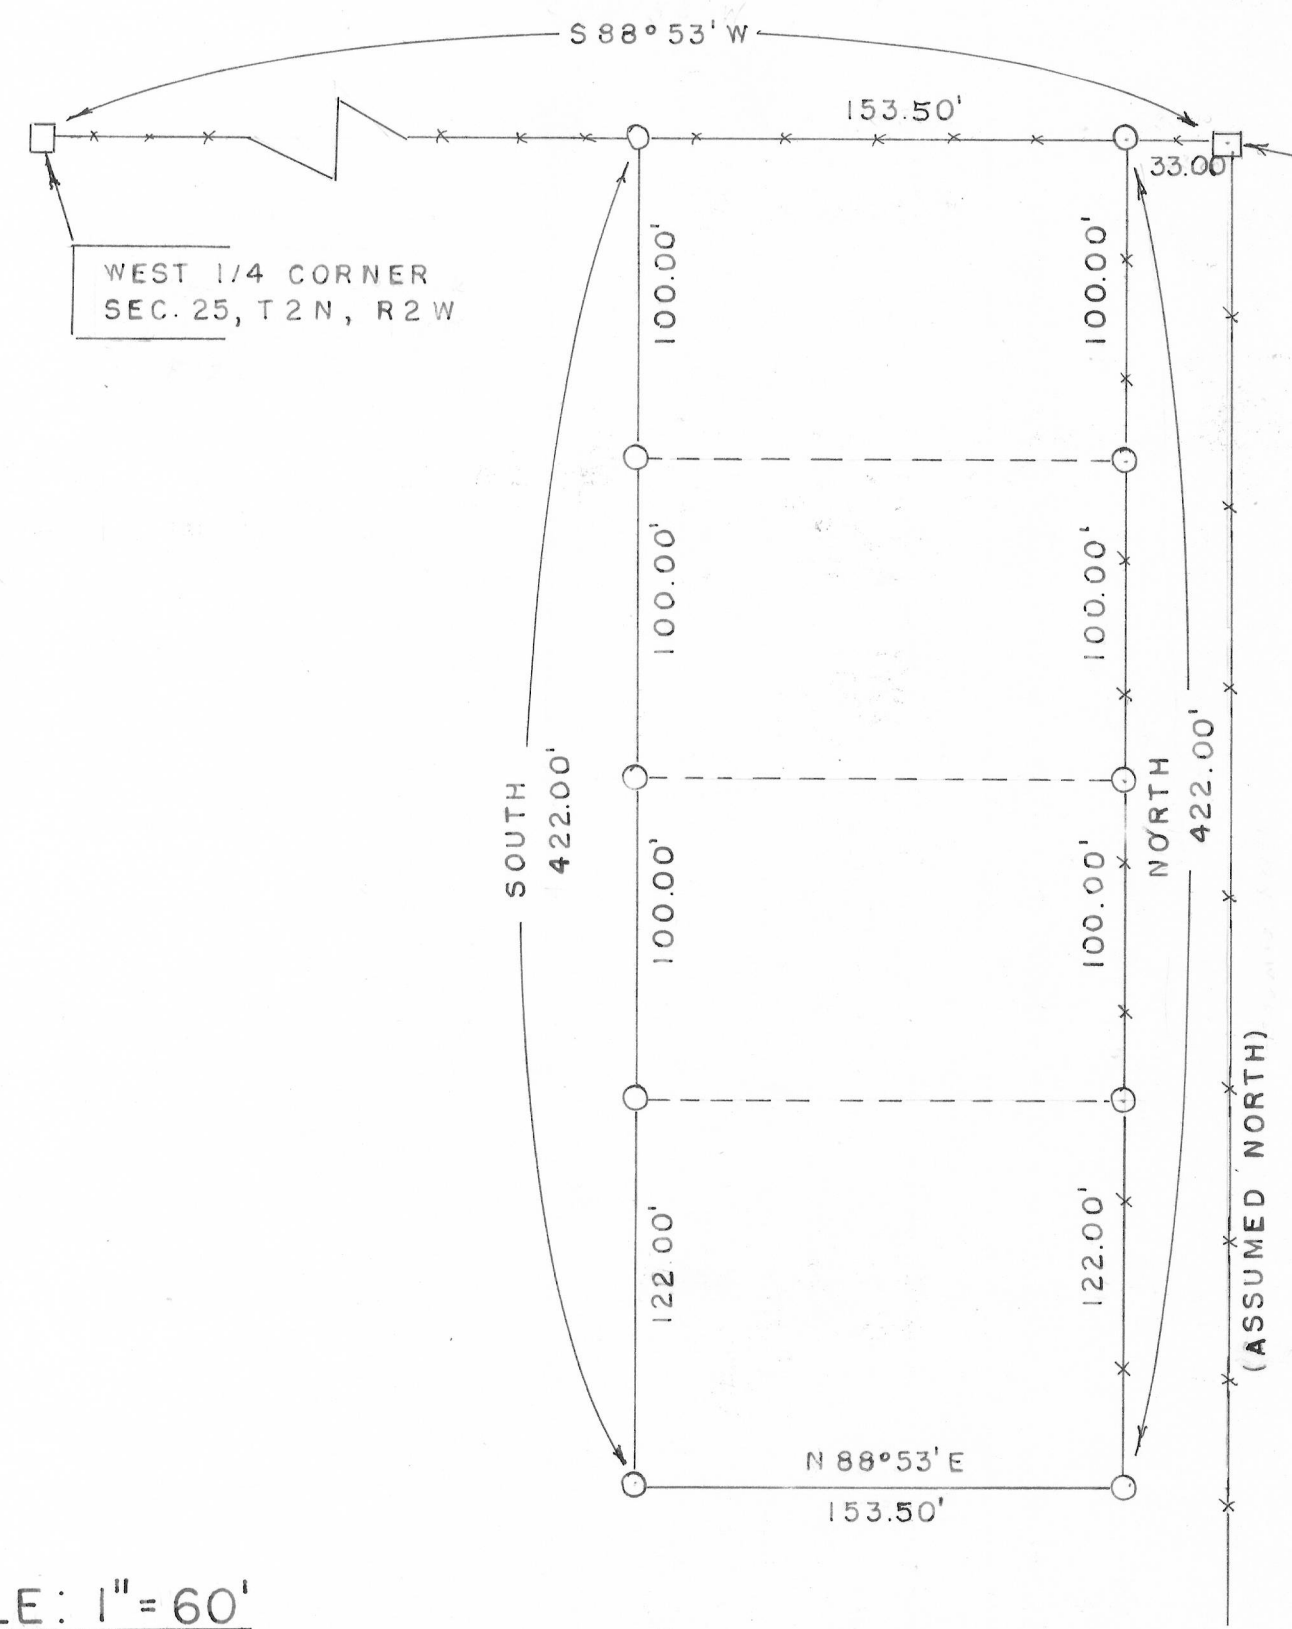

### DESCRIPTION:

Part of the Northwest Quarter ( N.W.1/4) of the Southwest Quarter (S.W. 1/4) of Section 25, T 2 N, R 2 W, of the 4th P.M., Grant County, Wisconsin described as follows to-wit:

Commence at the Northeast Corner of the N.W. 1/4 of the S.W. 1/4 of said Section 25;

thence South 88° 53' West 33.00 feet along the Northerly boundary of said Southwest Quarter to the place of beginning;

thence South 88° 53' West 153.50 feet along said Northerly boundary;

thence South 422.00 feet;

thence North 88° 53' East 153.50 feet;


thence North 422.00 feet to the place of beginning.

Parcel contains 1.49 acres more or less.

### LEGEND:

- 1" X 24" IRON PIPE PLACED BY THIS SURVEY
- CORNER POST
- x—x— EXISTING LINE FENCE

I certify that I have surveyed the above described parcel of land and that the attached or accompanying Plat is an accurate survey and a true representation thereof and correctly shows the exterior boundary lines of said parcel and the correct measurements thereof.

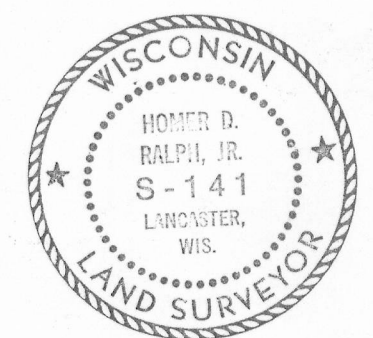

*David K. Krohn*  
 DAVID K. KROHN  
 11/8/75

*Homer D. Ralph, Jr.*  
 HOMER D RALPH, JR  
 SURVEYOR FOR GRANT  
 COUNTY, WISCONSIN

