

PLAT BEARINGS  
 REFERENCED TO THE SOUTH  
 LINE OF THE SE 1/4, SEC. 11,  
 T3N, R2W, GRANT CO., WISC.  
 ASSUMED BEG - EAST

± 0.69 ACRES  
 INCLUSIVE  
 ± 0.58 ACRES  
 EXCLUSIVE

SCALE: 1" = 50'  
 SURVEY: G.J. & J.O.  
 DRAWN: B.J.  
 FIELD BK. No. 34  
 OFFICE No. 785112

P.O.B. EAST, 1359.87'  
 & SOUTH, 3.65' FROM  
 THE S 1/4 COR., SEC. 11

**LEGEND**  
 Δ 24"x1" MIN. DIA. IRON  
 PIPE SET - 1.1316" / 11in. ft.  
 min. wgt.

Note: S 1/4 corner is iron pipe found  
 SE corner is fence post in concrete


**DESCRIPTION**

A parcel of land located in the SE 1/4 of the SE 1/4 of Section 11 and in the NE 1/4 of the NE 1/4 of Section 14, T3N, R2W, Grant County, Wisconsin, to wit:  
 Commencing at the South 1/4 corner of said Section 11; thence East, 1359.87' along the South line of said SE 1/4; thence South, 3.65' to the point of beginning, said point lying on the Easterly right-of-way line of Harrison Road and being marked by a 1" iron pipe; thence S89°21'E, 175.30' to a 1" iron pipe; thence N1°41'E, 142.24' to a 1" iron pipe; thence N89°16'W, 181.74' to a 1" iron pipe lying on said right-of-way line; thence continuing N89°16'W, 33.00' to the centerline of said Harrison Road; thence S0°54'25"E, 142.26' along said centerline; thence S89°21'E, 33.00' to the point of beginning.  
 Said parcel is subject to an easement for roadway purposes across the Westerly 33' thereof.  
 Said parcel contains 0.69 acres, more or less, inclusive of said easement and 0.58 acres, more or less, exclusive of said easement.

**SURVEYOR'S CERTIFICATE**

I hereby certify that I have made a survey according to the instructions furnished to me and that the plat drawn hereon is a correct representation of that survey to the best of my knowledge and belief.

*Laurence E. Schmit 10-25-78*  
 Laurence E. Schmit, RLS# S-1312  
 Southwest Engineering, Inc.  
 501 W. North St.  
 Dodgeville, Wi. 53533  
 608-935-3828

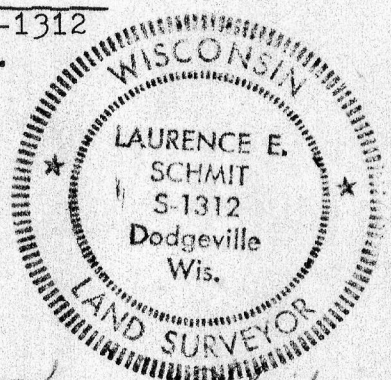

*Laurence E. Schmit 10-25-78*