


# DONALD LENZ — RUTH ANN SCHLUENZ SURVEY

SCALE: 1" = 40'

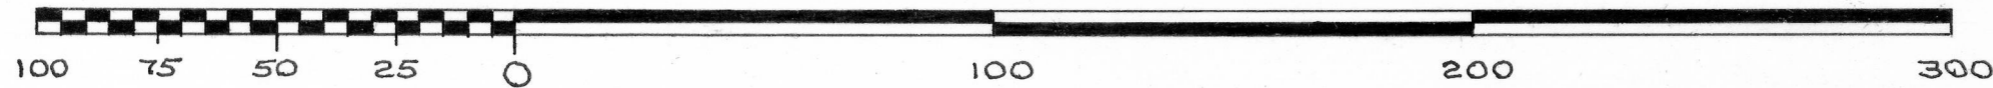

NORTHEAST CORNER OF THE N.E. 1/4 OF THE N.W. 1/4 OF SECTION 6, T 4 N, R 2 W, OF THE 4TH P.M., GRANT COUNTY, WISCONSIN.


N

### LEGEND:

- 1" X 24" IRON PIPE PLACED BY THIS SURVEY
- 1" X 24" IRON PIPE PLACED BY A PREVIOUS SURVEY
- △ RIGHT-OF-WAY POST
- ⊙ CHISELED HOLE PLACED BY THIS SURVEY

### NOTE:

SEE A SURVEY BY HOMER D. RALPH, JR., FOR LENZ DATED 7/10/73 - 7/12/73. ALL BEARINGS REFERENCED TO THIS PREVIOUS SURVEY.

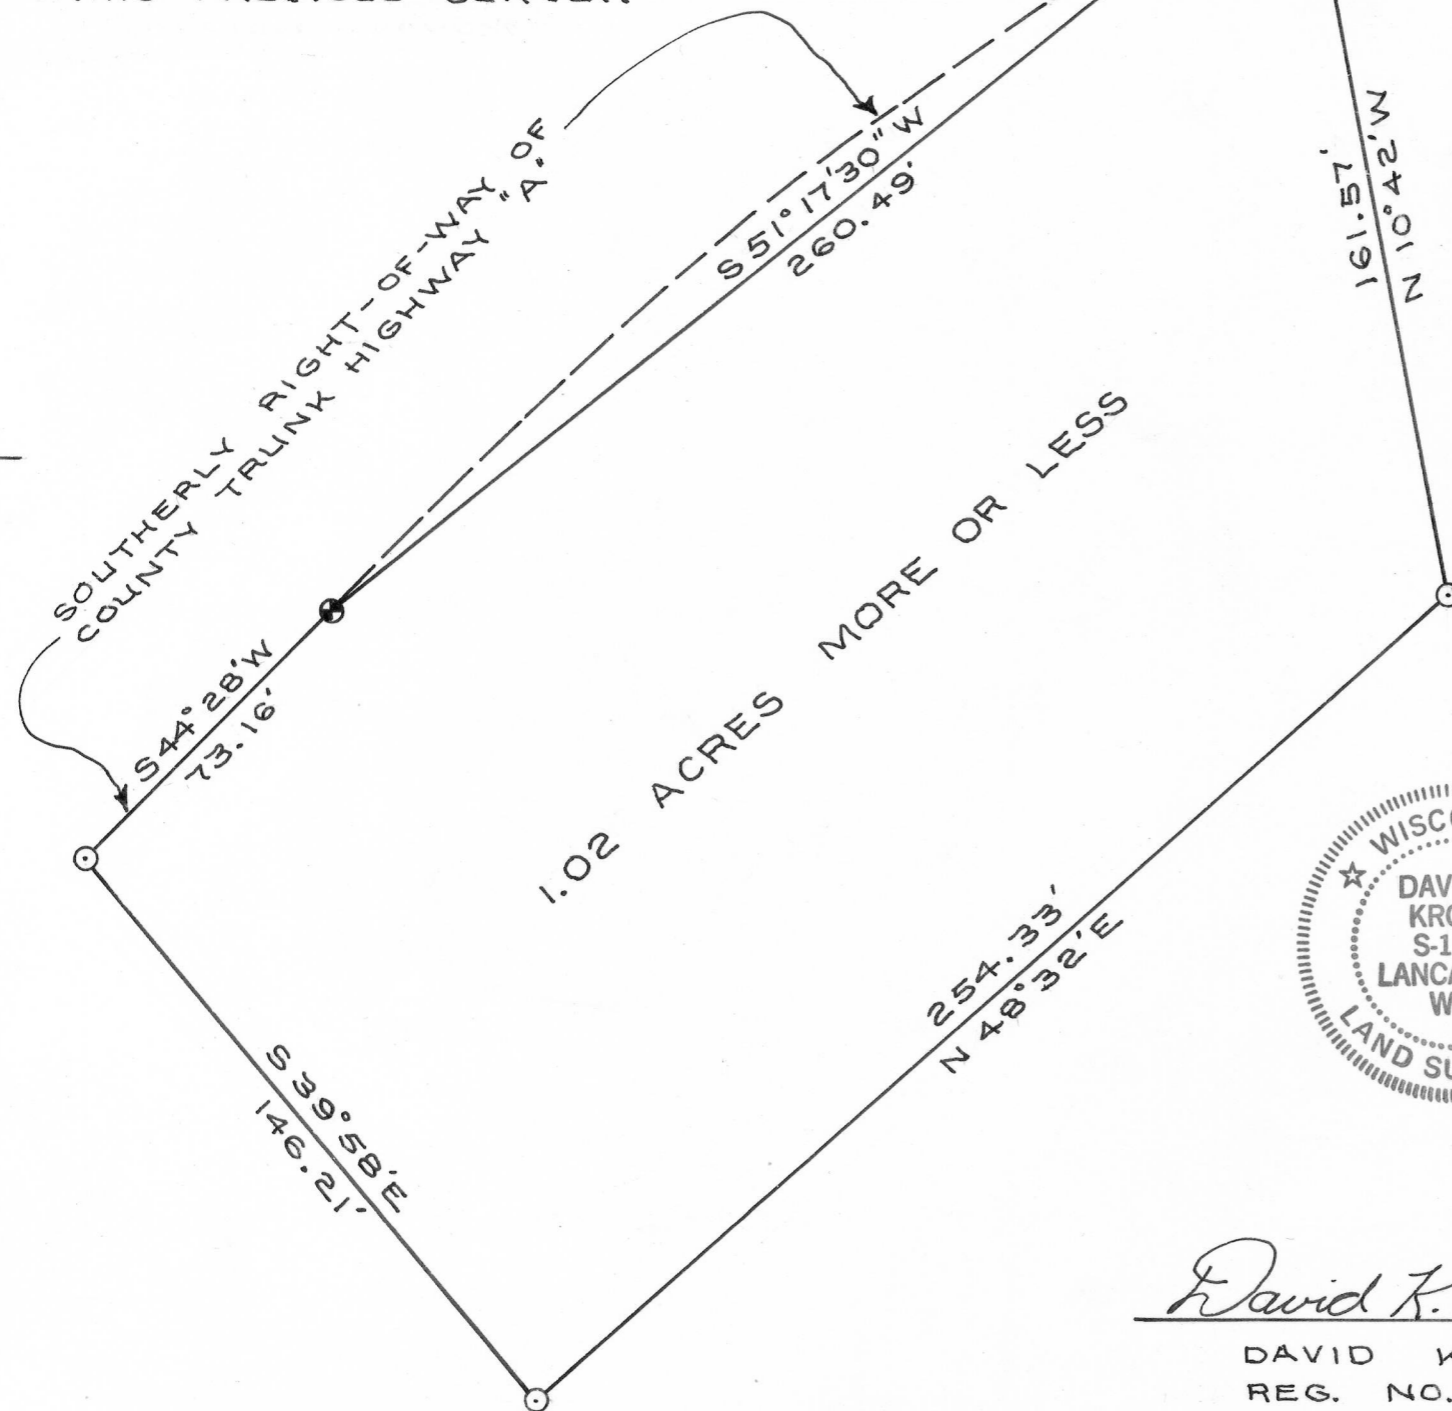

### DESCRIPTION:

Part of the N.E. 1/4 of the N.W. 1/4 of Section 6, T 4 N, R 2 W, of the 4th P.M., Grant County, Wisconsin, described as follows to-wit:

Commence at the Northeast Corner of the N.E. 1/4 of the N.W. 1/4 of said Section 6;

thence South 37.30 feet;

thence West 23.00 feet;

thence North 89° 03' West 342.35 feet;

thence South 74° 34' West 620.73 feet to a point on the arc of a curve of the Southerly right-of-way of County Trunk Highway "A", said curve being concave to the South, whose radius is 1096.00 feet and from which a chord bears South 51° 17' 30" West 260.49 feet, said point being the point of beginning;

thence Southwesterly 261.11 feet along the arc of said curve and said Southerly right-of-way to the point of tangency of said curve, and a 1 inch diameter iron pipe;

thence South 44° 28' West 73.16 feet along said Southerly right-of-way to a 1 inch diameter iron pipe;

thence South 39° 58' East 146.21 feet to a 1 inch diameter iron pipe;

thence North 48° 32' East 254.33 feet to a 1 inch diameter iron pipe;

thence North 10° 42' West 161.57 feet to a 1 inch diameter iron pipe on the arc of a curve of the Southerly right-of-way of County Trunk Highway "A", and the point of beginning.

Containing 1.02 acres more or less.

I certify that I have surveyed the above described parcel of land and that the attached or accompanying plat is an accurate survey and true representation thereof and correctly shows the exterior boundary lines of said parcel and the correct measurements thereof.

Dated this 20th day of April, 1977.



*David K. Krohn*  
 DAVID K. KROHN  
 REG. NO. 1309  
 4/15/77 - 4/20/77