

EDITH BECKER MORGAN — GERMAN EVANGELICAL CHURCH SURVEY

DESCRIPTION:

Part of the S.E.1/4 of the S.W.1/4 of Section 19, T 5 N, R 2 W, of the 4th P.M., Grant County, Wisconsin, described as follows to-wit:

Commence at the Southwest Corner of the S.E.1/4 of the S.W.1/4 of said Section 19;

thence North 00° 35' West 803.97 feet along the West line of the S.E.1/4 of the S.W.1/4 of said Section 19, to a point on the centerline of U.S. Highway #61 and the point of beginning;

thence North 26° 17' East 108.20 feet along said centerline to the point of curvature of a curve, concave to the Northwest, whose radius is 2,864.79 feet, and from which a chord bears North 21° 40' 10" East 460.88 feet;

thence Northeasterly 461.39 feet along the arc of said curve and along said centerline; to a point on the North Line of the S.E.1/4 of the S.W.1/4 of said Section 19;

thence South 88° 48' West 223.44 feet along said North Line to the Northwest Corner of the S.E.1/4 of the S.W.1/4 of said Section 19, and a 1 inch diameter iron pipe;


thence South 00° 35' East 520.67 feet along the West line of the S.E.1/4 of the S.W.1/4 of said Section 19 to a point on the centerline of U.S. Highway #61, and the point of beginning.

Containing 1.45 acres more or less inclusive of highway right-of-way.

I certify that I have surveyed the above described parcel of land and that the attached or accompanying plat is an accurate survey and true representation thereof and correctly shows the exterior boundary lines of said parcel and the correct measurements thereof.

DATED THIS 13TH DAY OF JULY, 1977.

SCALE: 1" = 60'

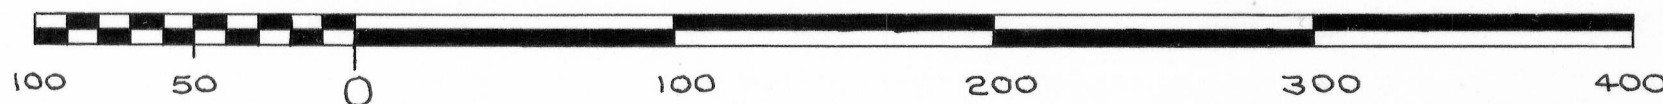

NORTH LINE OF THE S.E.1/4 OF THE S.W.1/4 OF SEC. 19, T 5 N, R 2 W.

NORTHWEST CORNER OF THE S.E.1/4 OF THE S.W.1/4 OF SEC. 19, T 5 N, R 2 W.

LEGEND:

- 1" x 24" IRON PIPE PLACED BY THIS SURVEY
- P.K. NAIL PLACED BY THIS SURVEY



David K. Krohn
 DAVID K. KROHN
 REG. NO. 1309
 7/1/77 - 7/13/77

