



NELLIE JOHNSON ESTATE — SURVEY

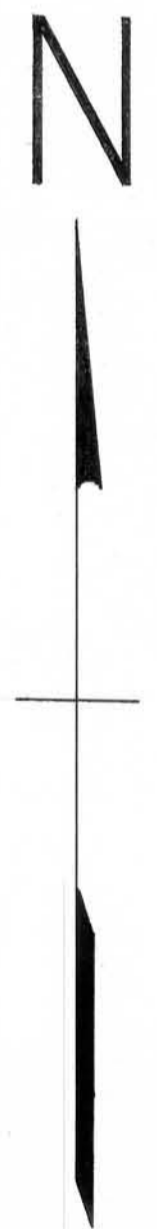

SCALE: 1" = 20'

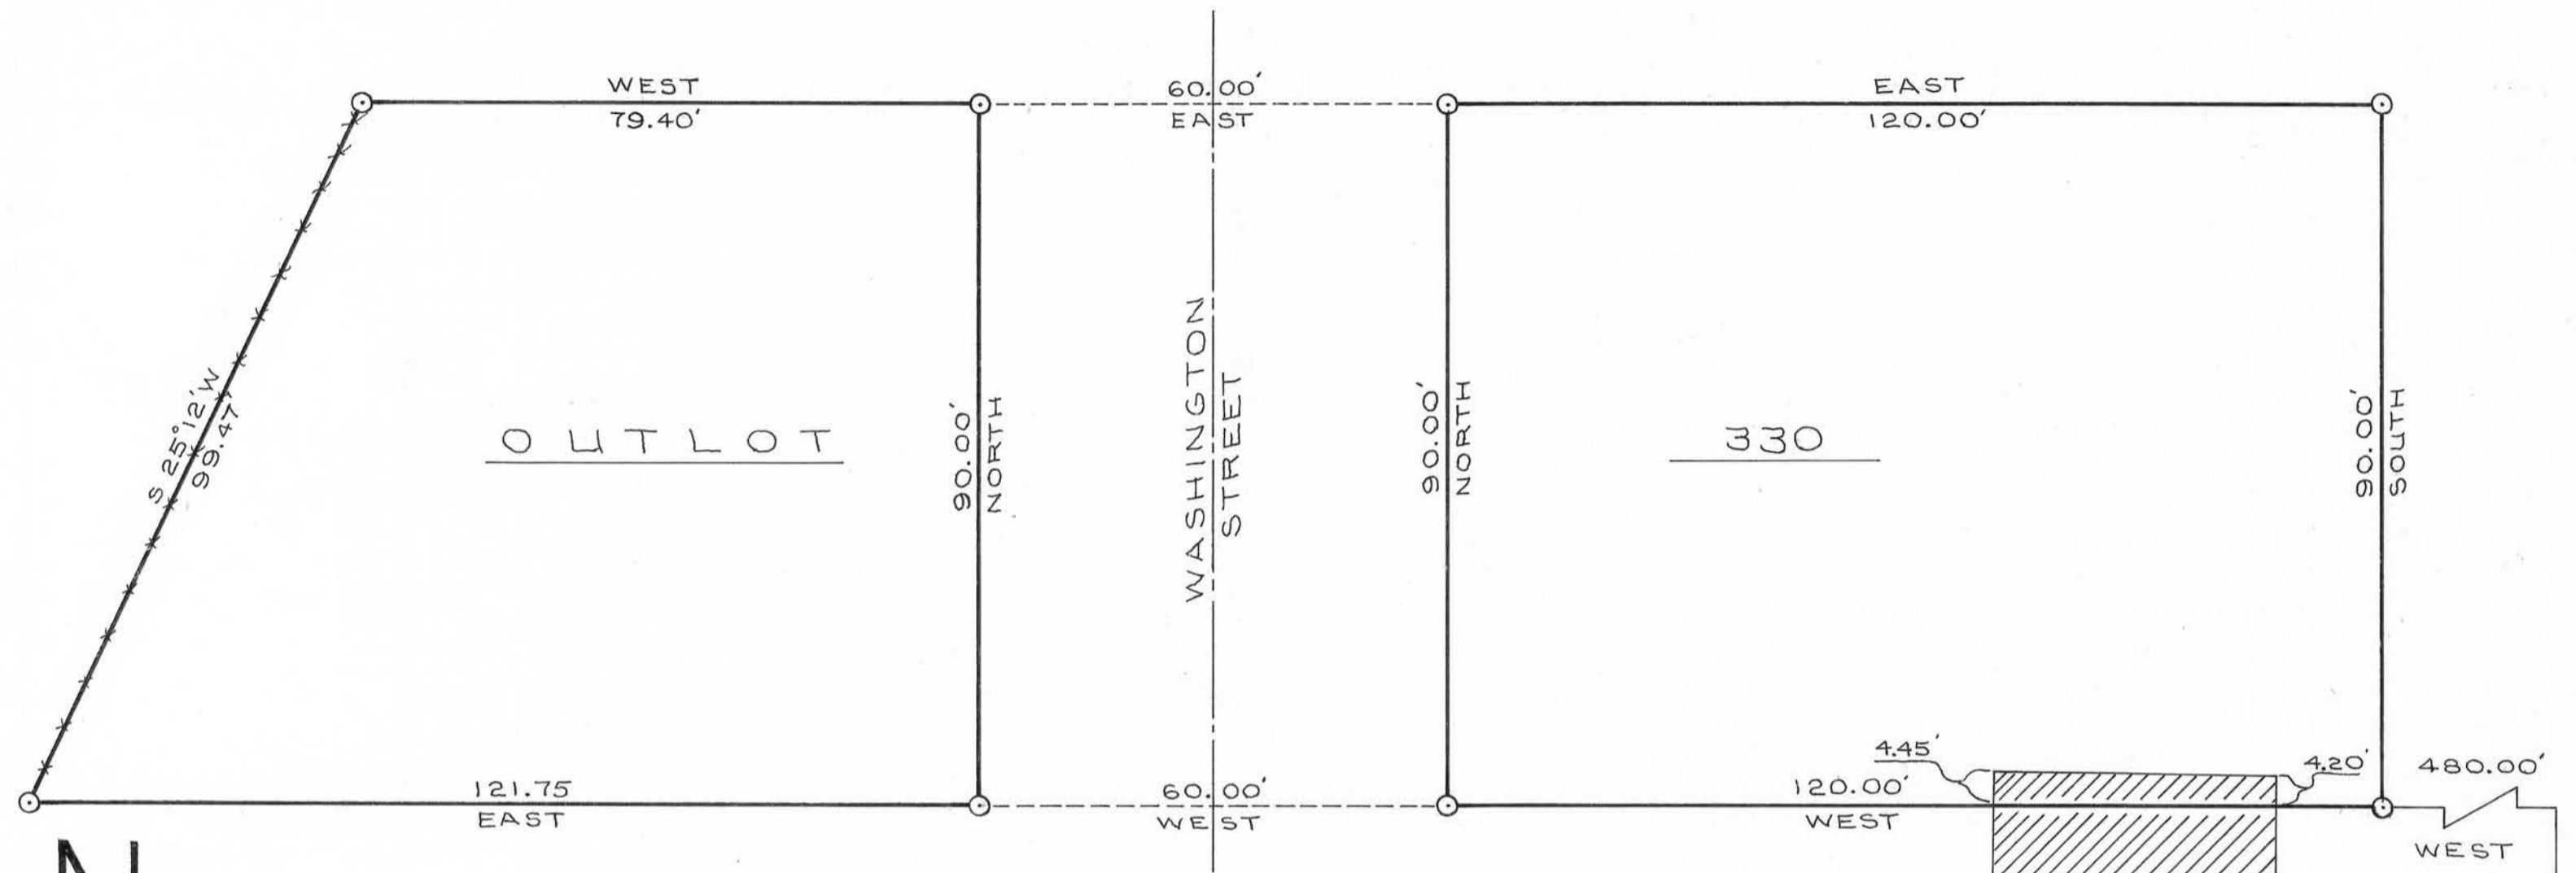

LEGEND:

- 1" x 24" IRON PIPE PLACED BY THIS SURVEY
- ***** FENCE

David K. Krohn
 DAVID K. KROHN
 REG. NO. 1309
 9/26/76 - 9/30/76



NORTHWEST CORNER OF BLOCK 2, OF FIELD'S ADDITION TO THE VILLAGE (NOW CITY) OF FENNIMORE, GRANT COUNTY, WISCONSIN.

720.00' NORTH

NELLIE JOHNSON ESTATE SURVEY

DESCRIPTION: PARCEL EAST OF WASHINGTON STREET

A part of the N.1/2 of the N.W.1/4 of Section 19, T 6 N, R 2 W, of the 4th P.M., Grant County, Wisconsin, described as follows to-wit:

Commence at the Northwest Corner of Block 2 of Field's Addition to the Village (now City) of Fennimore, Grant County, Wisconsin, according to the recorded map or plat thereof;

thence North 720.00 feet;

thence West 480.00 feet to a 1 inch diameter iron pipe and the point of beginning;

thence West 120.00 feet to a 1 inch diameter iron pipe on the Eastern right-of-way of Washington Street;

thence North 90.00 feet along said Eastern right-of-way to a 1 inch diameter iron pipe;

thence East 120.00 feet to a 1 inch diameter iron pipe;

thence South 90.00 feet to the point of beginning.

The above described parcel of land being a part of Outlot 330 of the Assessment Plat of the City of Fennimore, Grant County, Wisconsin, as recorded in Volume 1 of Plats, Page 42.

I certify that I have surveyed the above described parcel of land and that the attached or accompanying plat is an accurate survey and true representation thereof and correctly shows the exterior boundary lines of said parcel and the correct measurements thereof.

Dated this 30th day of September, 1976.

David K. Krohn

David, K. Krohn

Reg. No. 1309

9/26/76 - 9/30/76



NELLIE JOHNSON ESTATE SURVEY

DESCRIPTION: PARCEL WEST OF WASHINGTON STREET

A part of the N.1/2 of the N.W.1/4 of Section 19, T 6 N, R 2 W, of the 4th P.M., Grant County, Wisconsin, described as follows to-wit:

Commence at the Northwest Corner of Block 2 of Field's Addition to the Village (now City) of Fennimore, Grant County, Wisconsin, according to the recorded map or plat thereof;

thence North 720.00 feet;

thence West 660.00 feet to a 1 inch diameter iron pipe on the Western right-of-way of Washington Street and the point of beginning;

thence North 90.00 feet along said Western right-of-way to a 1 inch diameter iron pipe;

thence West 79.40 feet to a 1 inch diameter iron pipe;

thence South 25° 12' West 99.47 feet to a 1 inch diameter iron pipe;

thence East 121.75 feet to a point on the Western right-of-way of Washington Street and the point of beginning.

The above parcel of land also being described as part of Outlot 330 of the Assessment Plat of the City of Fennimore, Grant County, Wisconsin, as recorded in Volume 1 of Plats, Page 42.

I certify that I have surveyed the above described parcel of land and that the attached or accompanying plat is an accurate survey and true representation thereof and correctly shows the exterior boundary lines of said parcel and the correct measurements thereof.

Dated this 30th day of September, 1976.

David K. Krohn

David K. Krohn

Reg. No. 1309

9/26/76 - 9/30/76

