


NOE SURVEY



N

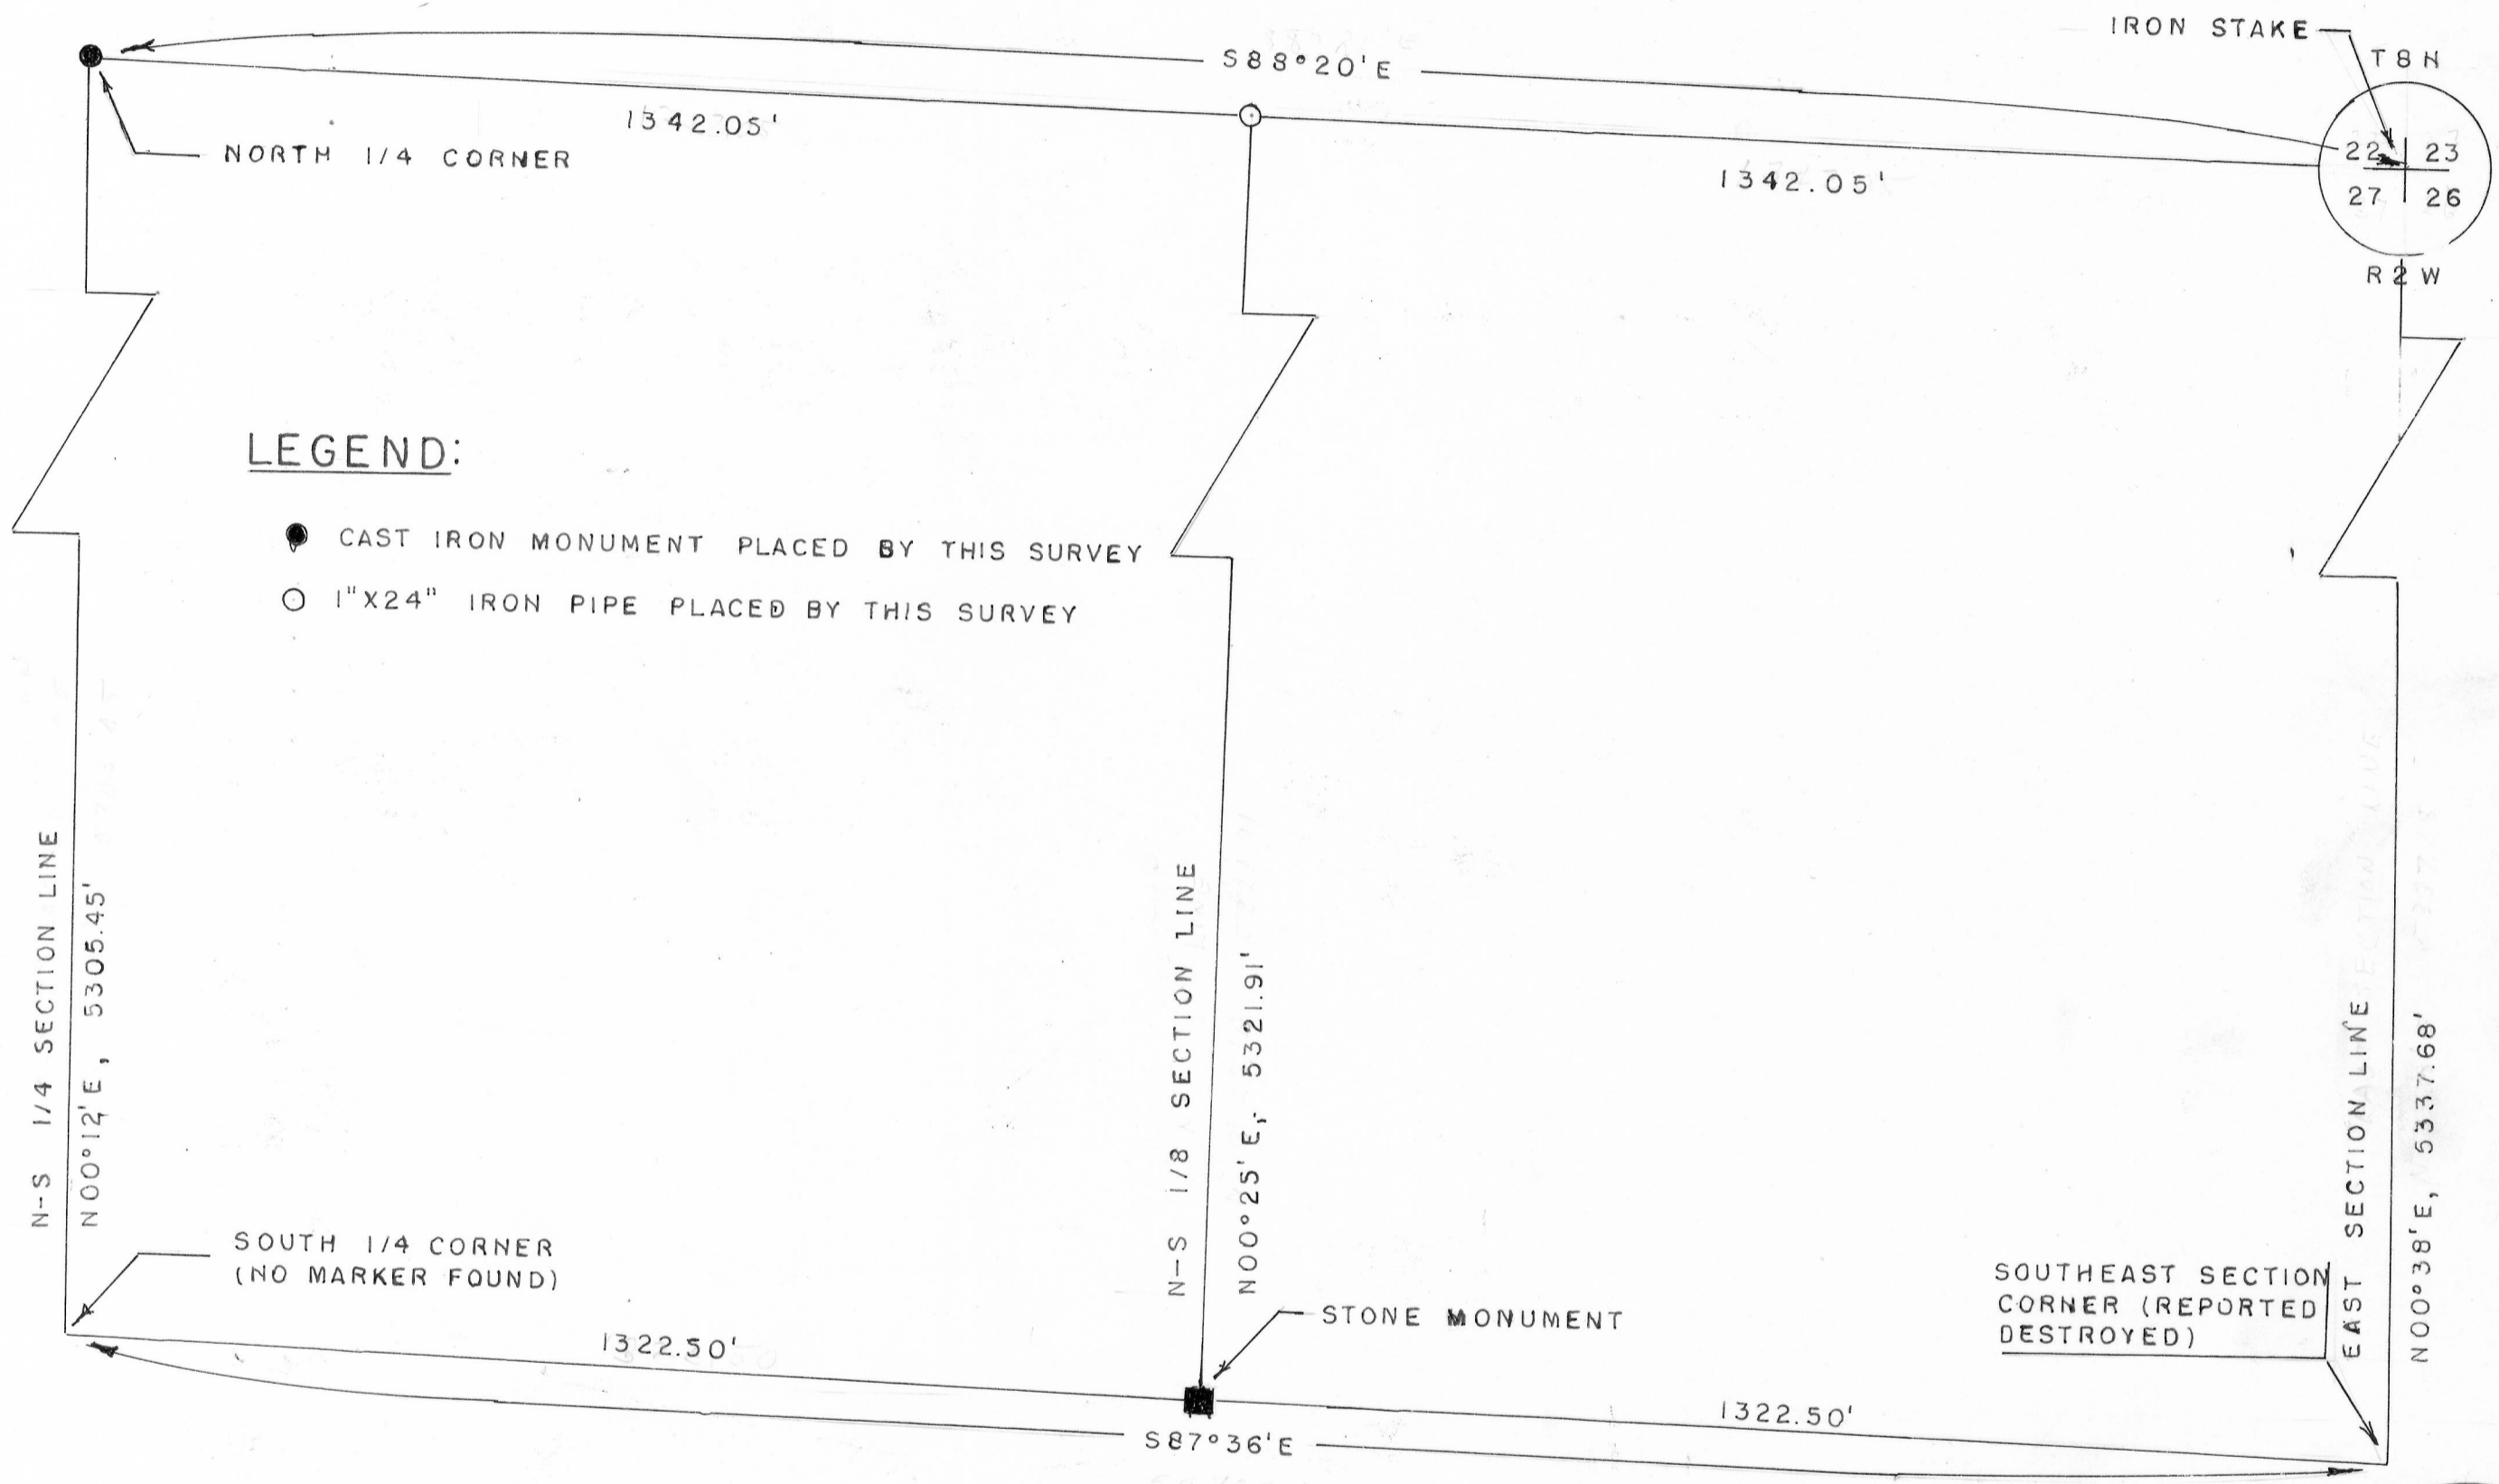

LEGEND:

- CAST IRON MONUMENT PLACED BY THIS SURVEY
- 1"X24" IRON PIPE PLACED BY THIS SURVEY

SCALE: 1" = 200'

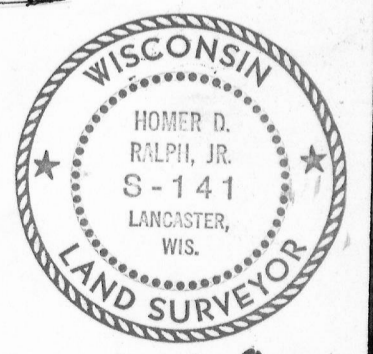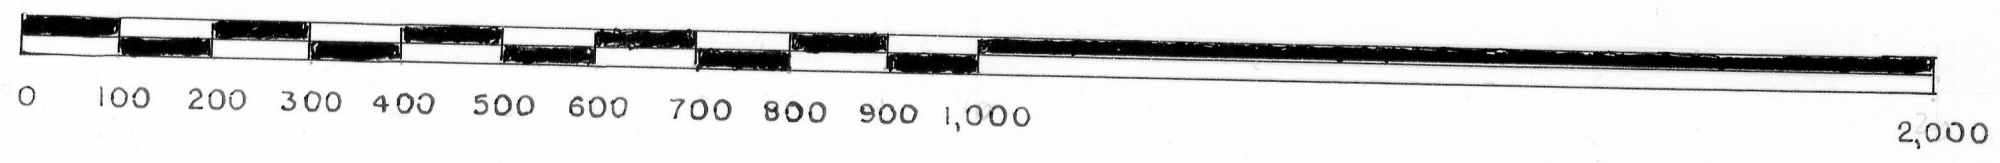

David K. Krohn
 DAVID K. KROHN
 4/14/76 - 5/21/76

Homer D. Ralph, Jr.
 HOMER D. RALPH, JR.
 SURVEYOR FOR GRANT
 COUNTY, WISCONSIN