

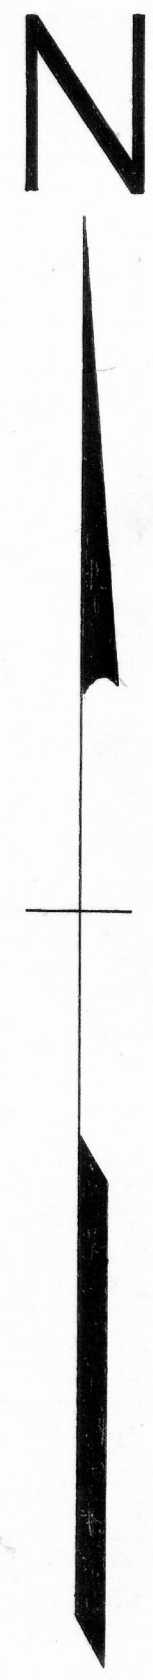


DICK BRODBECK SURVEY

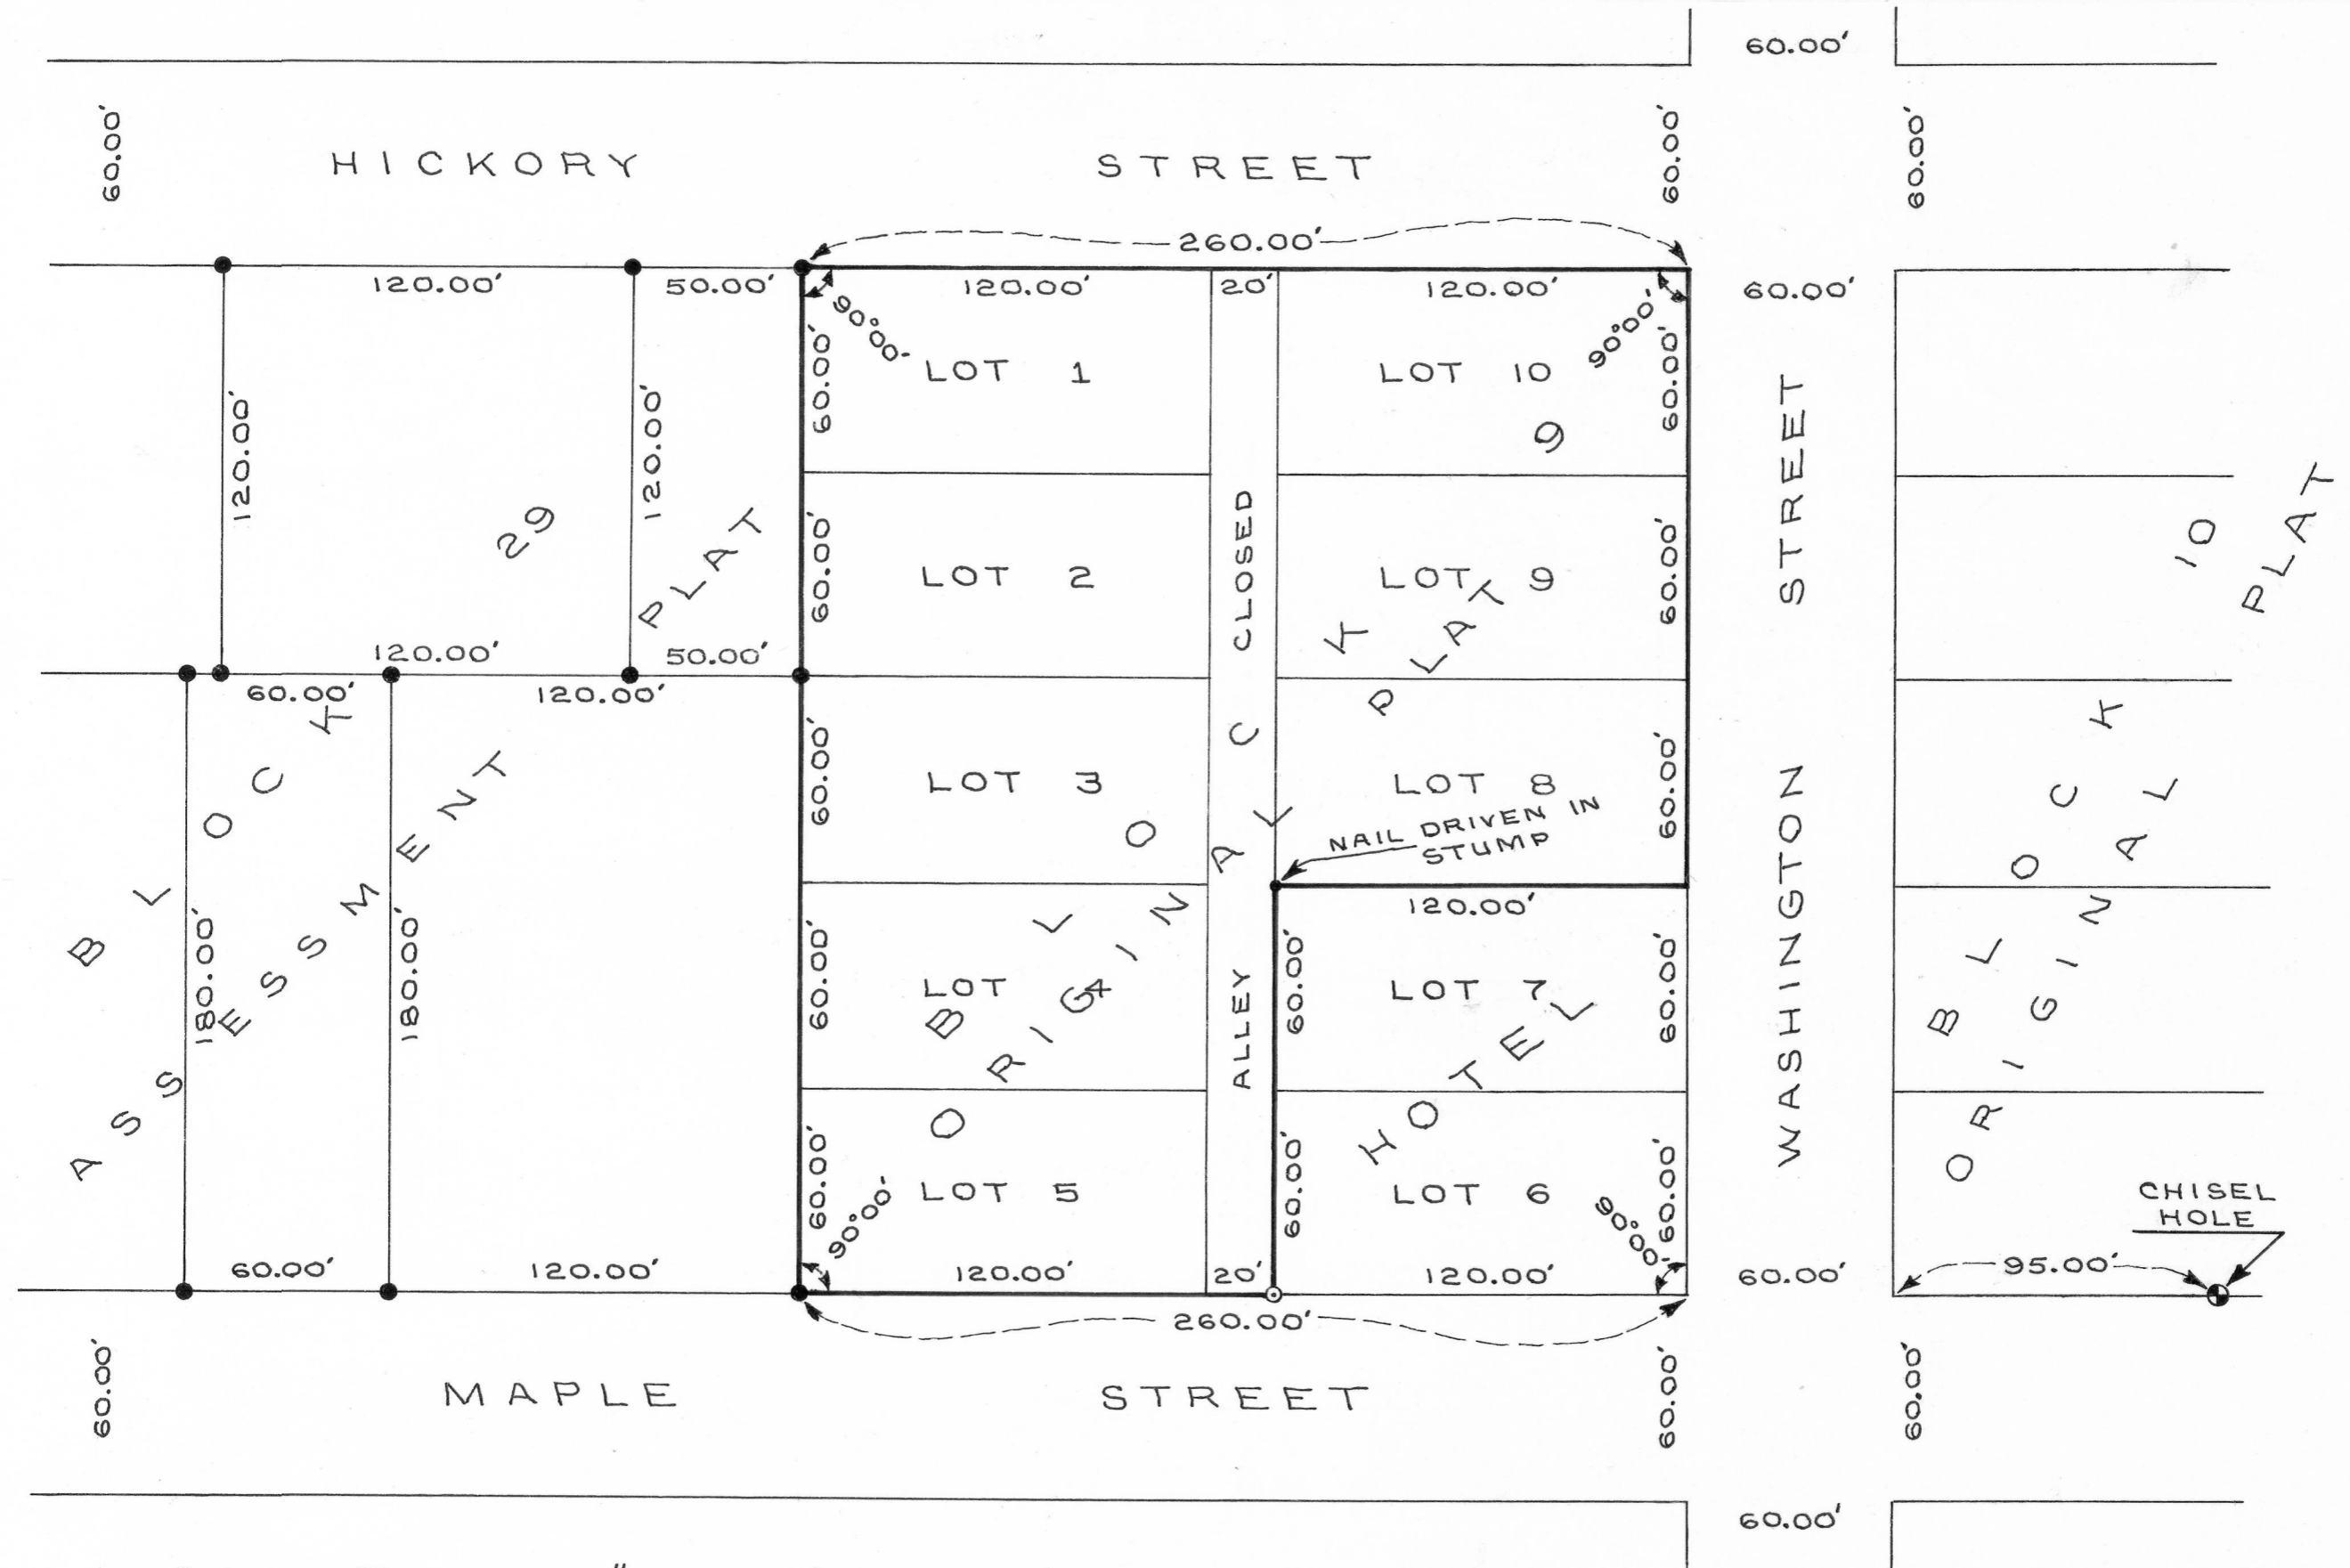

SCALE: 1" = 50'

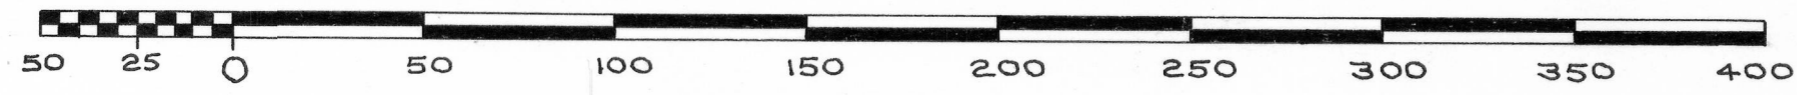

LEGEND:

- 1" x 24" IRON PIPE PLACED BY THIS SURVEY
- 1" x 24" IRON PIPE PLACED BY A PREVIOUS SURVEY

CITY OF LANCASTER
 GRANT COUNTY,
 WISCONSIN

David K. Krohn
 DAVID K. KROHN
 REG. NO. 1309
 5/26/77 - 5/31/77

