
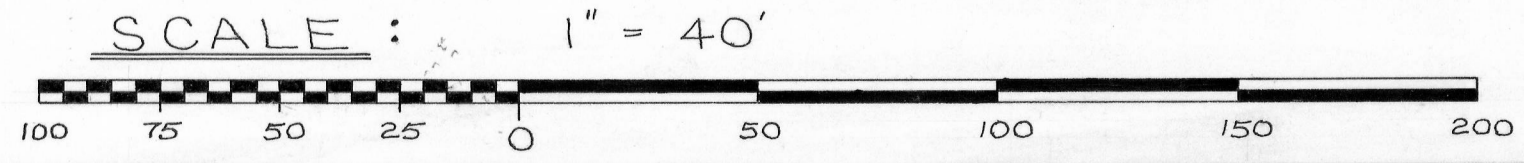


SCOTT — OLSON — KNOX — DOBSON — CITY OF LANCASTER SURVEY

LEGEND:

- 1" X 24" IRON PIPE PLACED BY THIS SURVEY
- P.K. NAIL PLACED BY THIS SURVEY
- HEAVY LINES INDICATE OWNERSHIP BOUNDARIES
- LIGHT LINES INDICATE LOT LINES

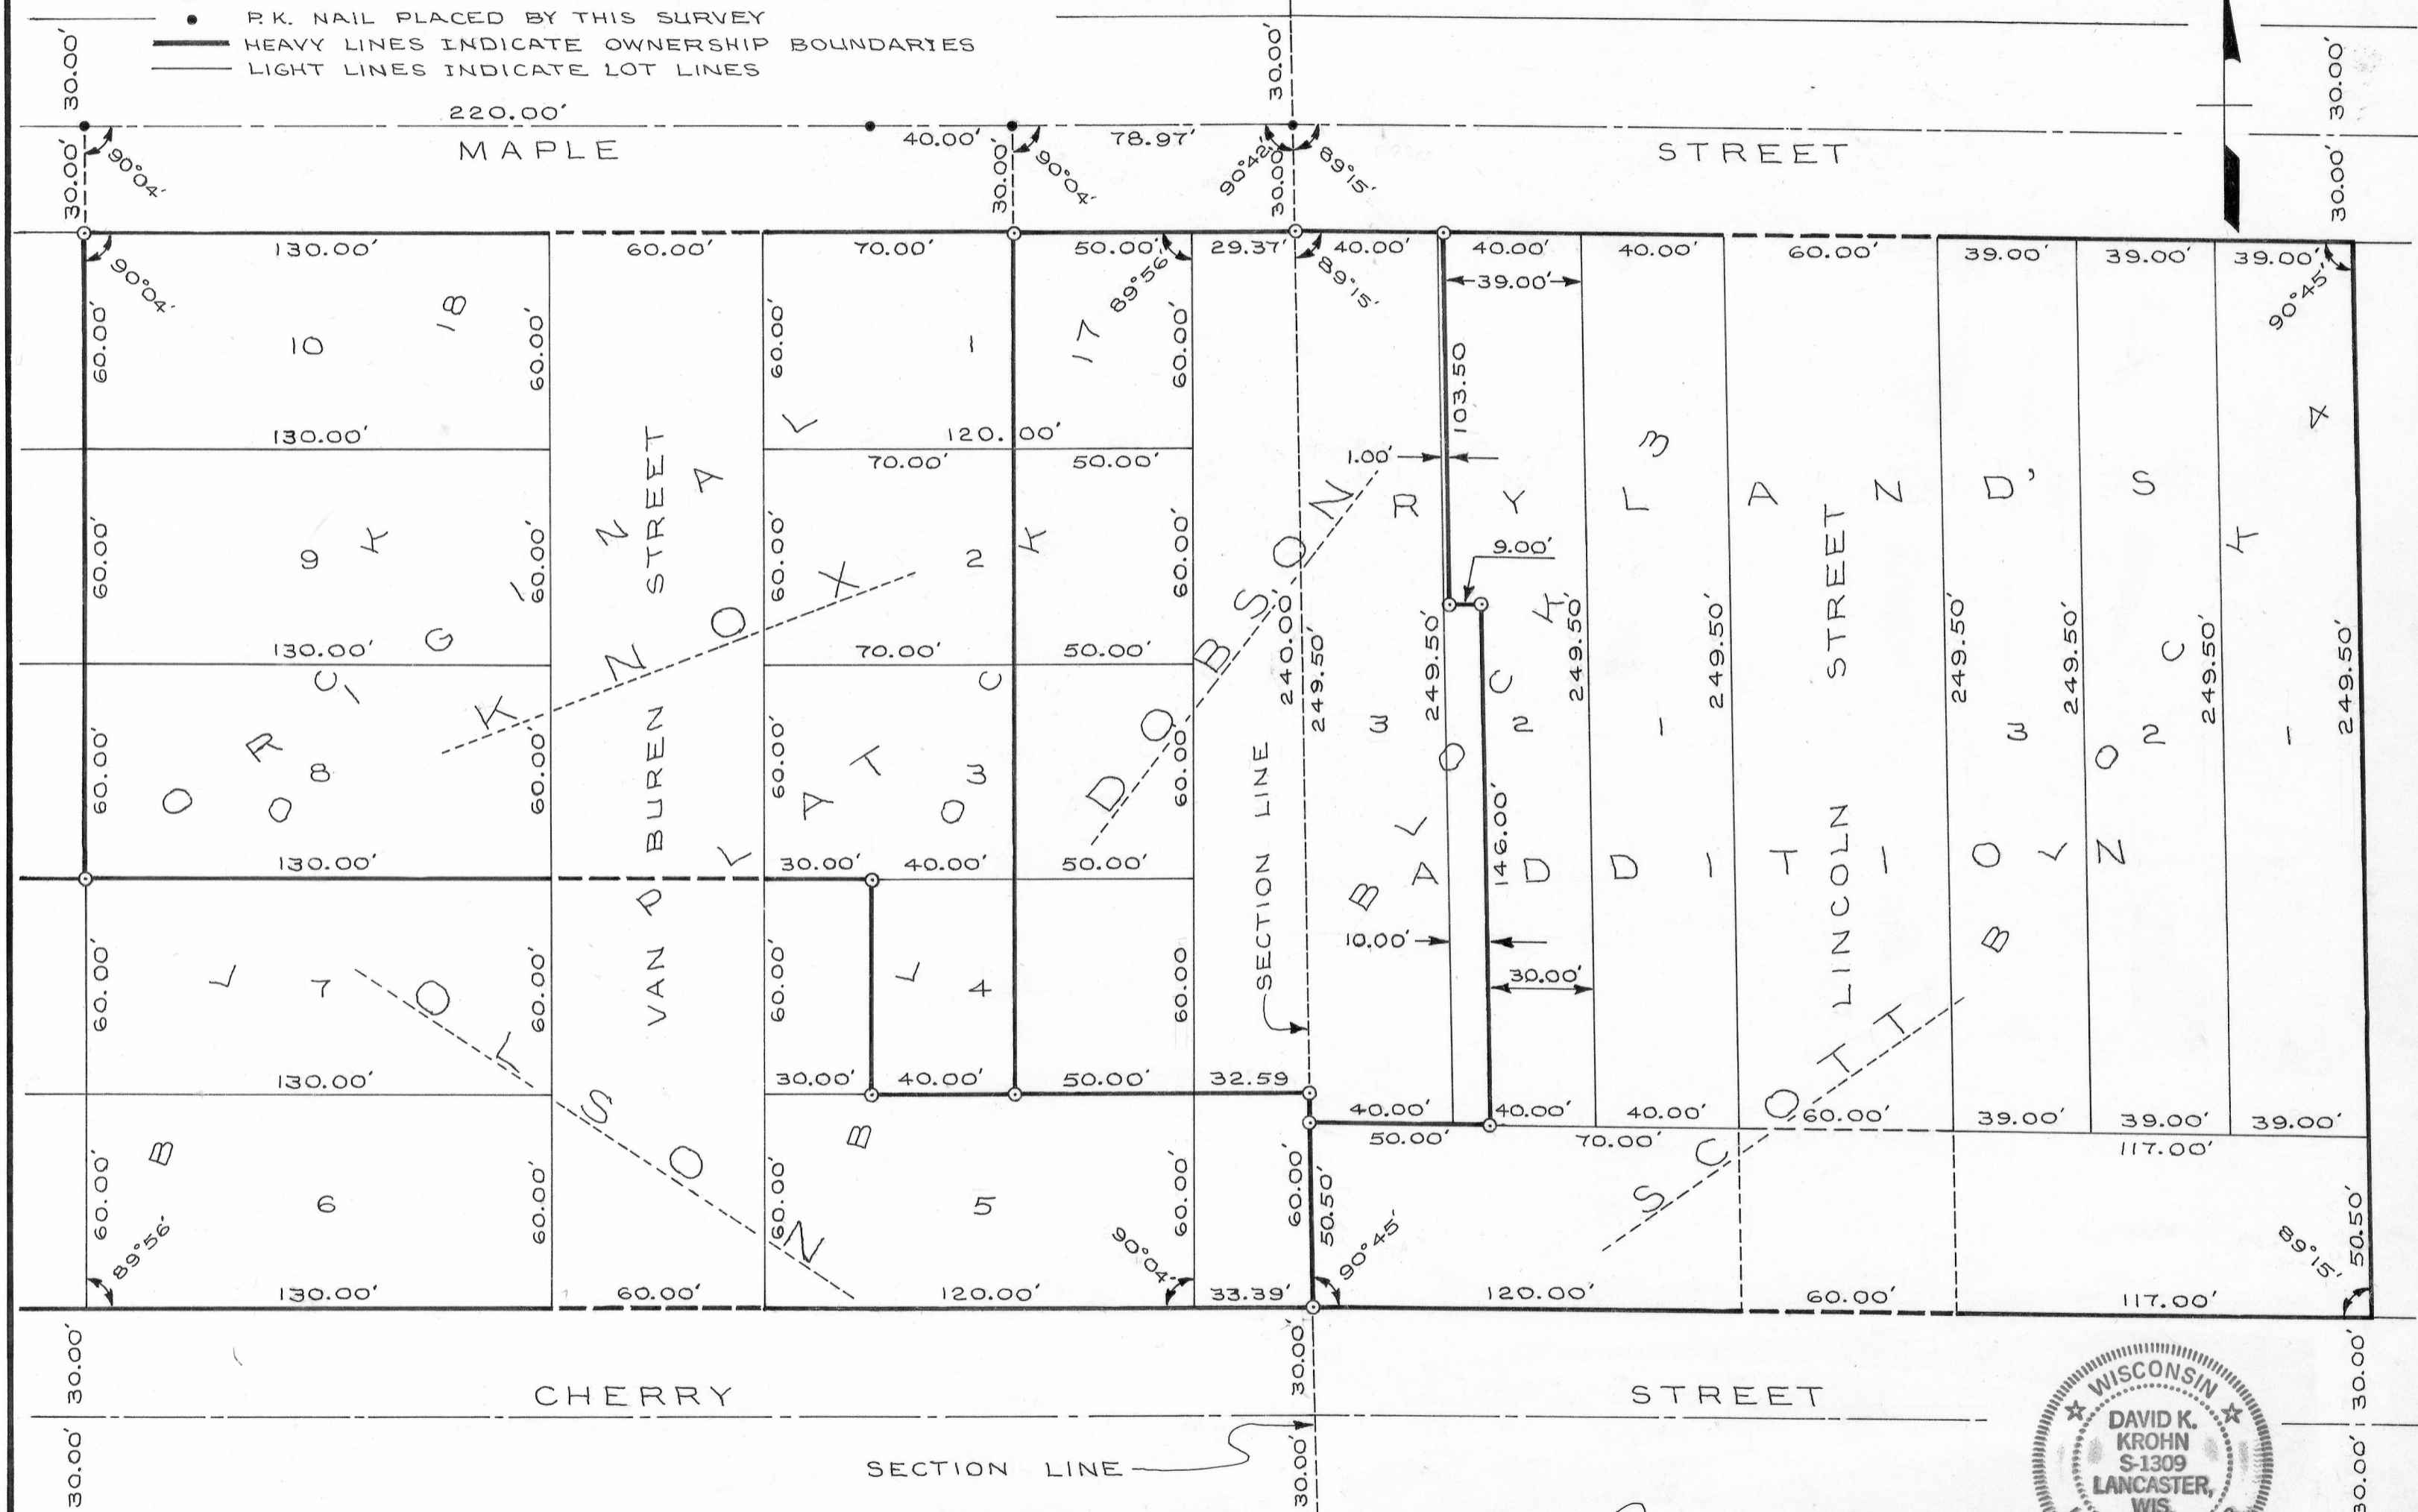

David K. Krohn
 DAVID K. KROHN
 REG. NO. 1309
 9/30/76 - 10/6/76

