


RONALD A. WRIGHT — ROBERT LUCEY SURVEY

LEGEND :

- 1" x 24" IRON PIPE PLACED BY THIS SURVEY
- NAIL PLACED BY THIS SURVEY
- NAIL PLACED BY PREVIOUS SURVEY
- EXISTING FENCE LINE
- EXISTING WOODEN CORNER POST

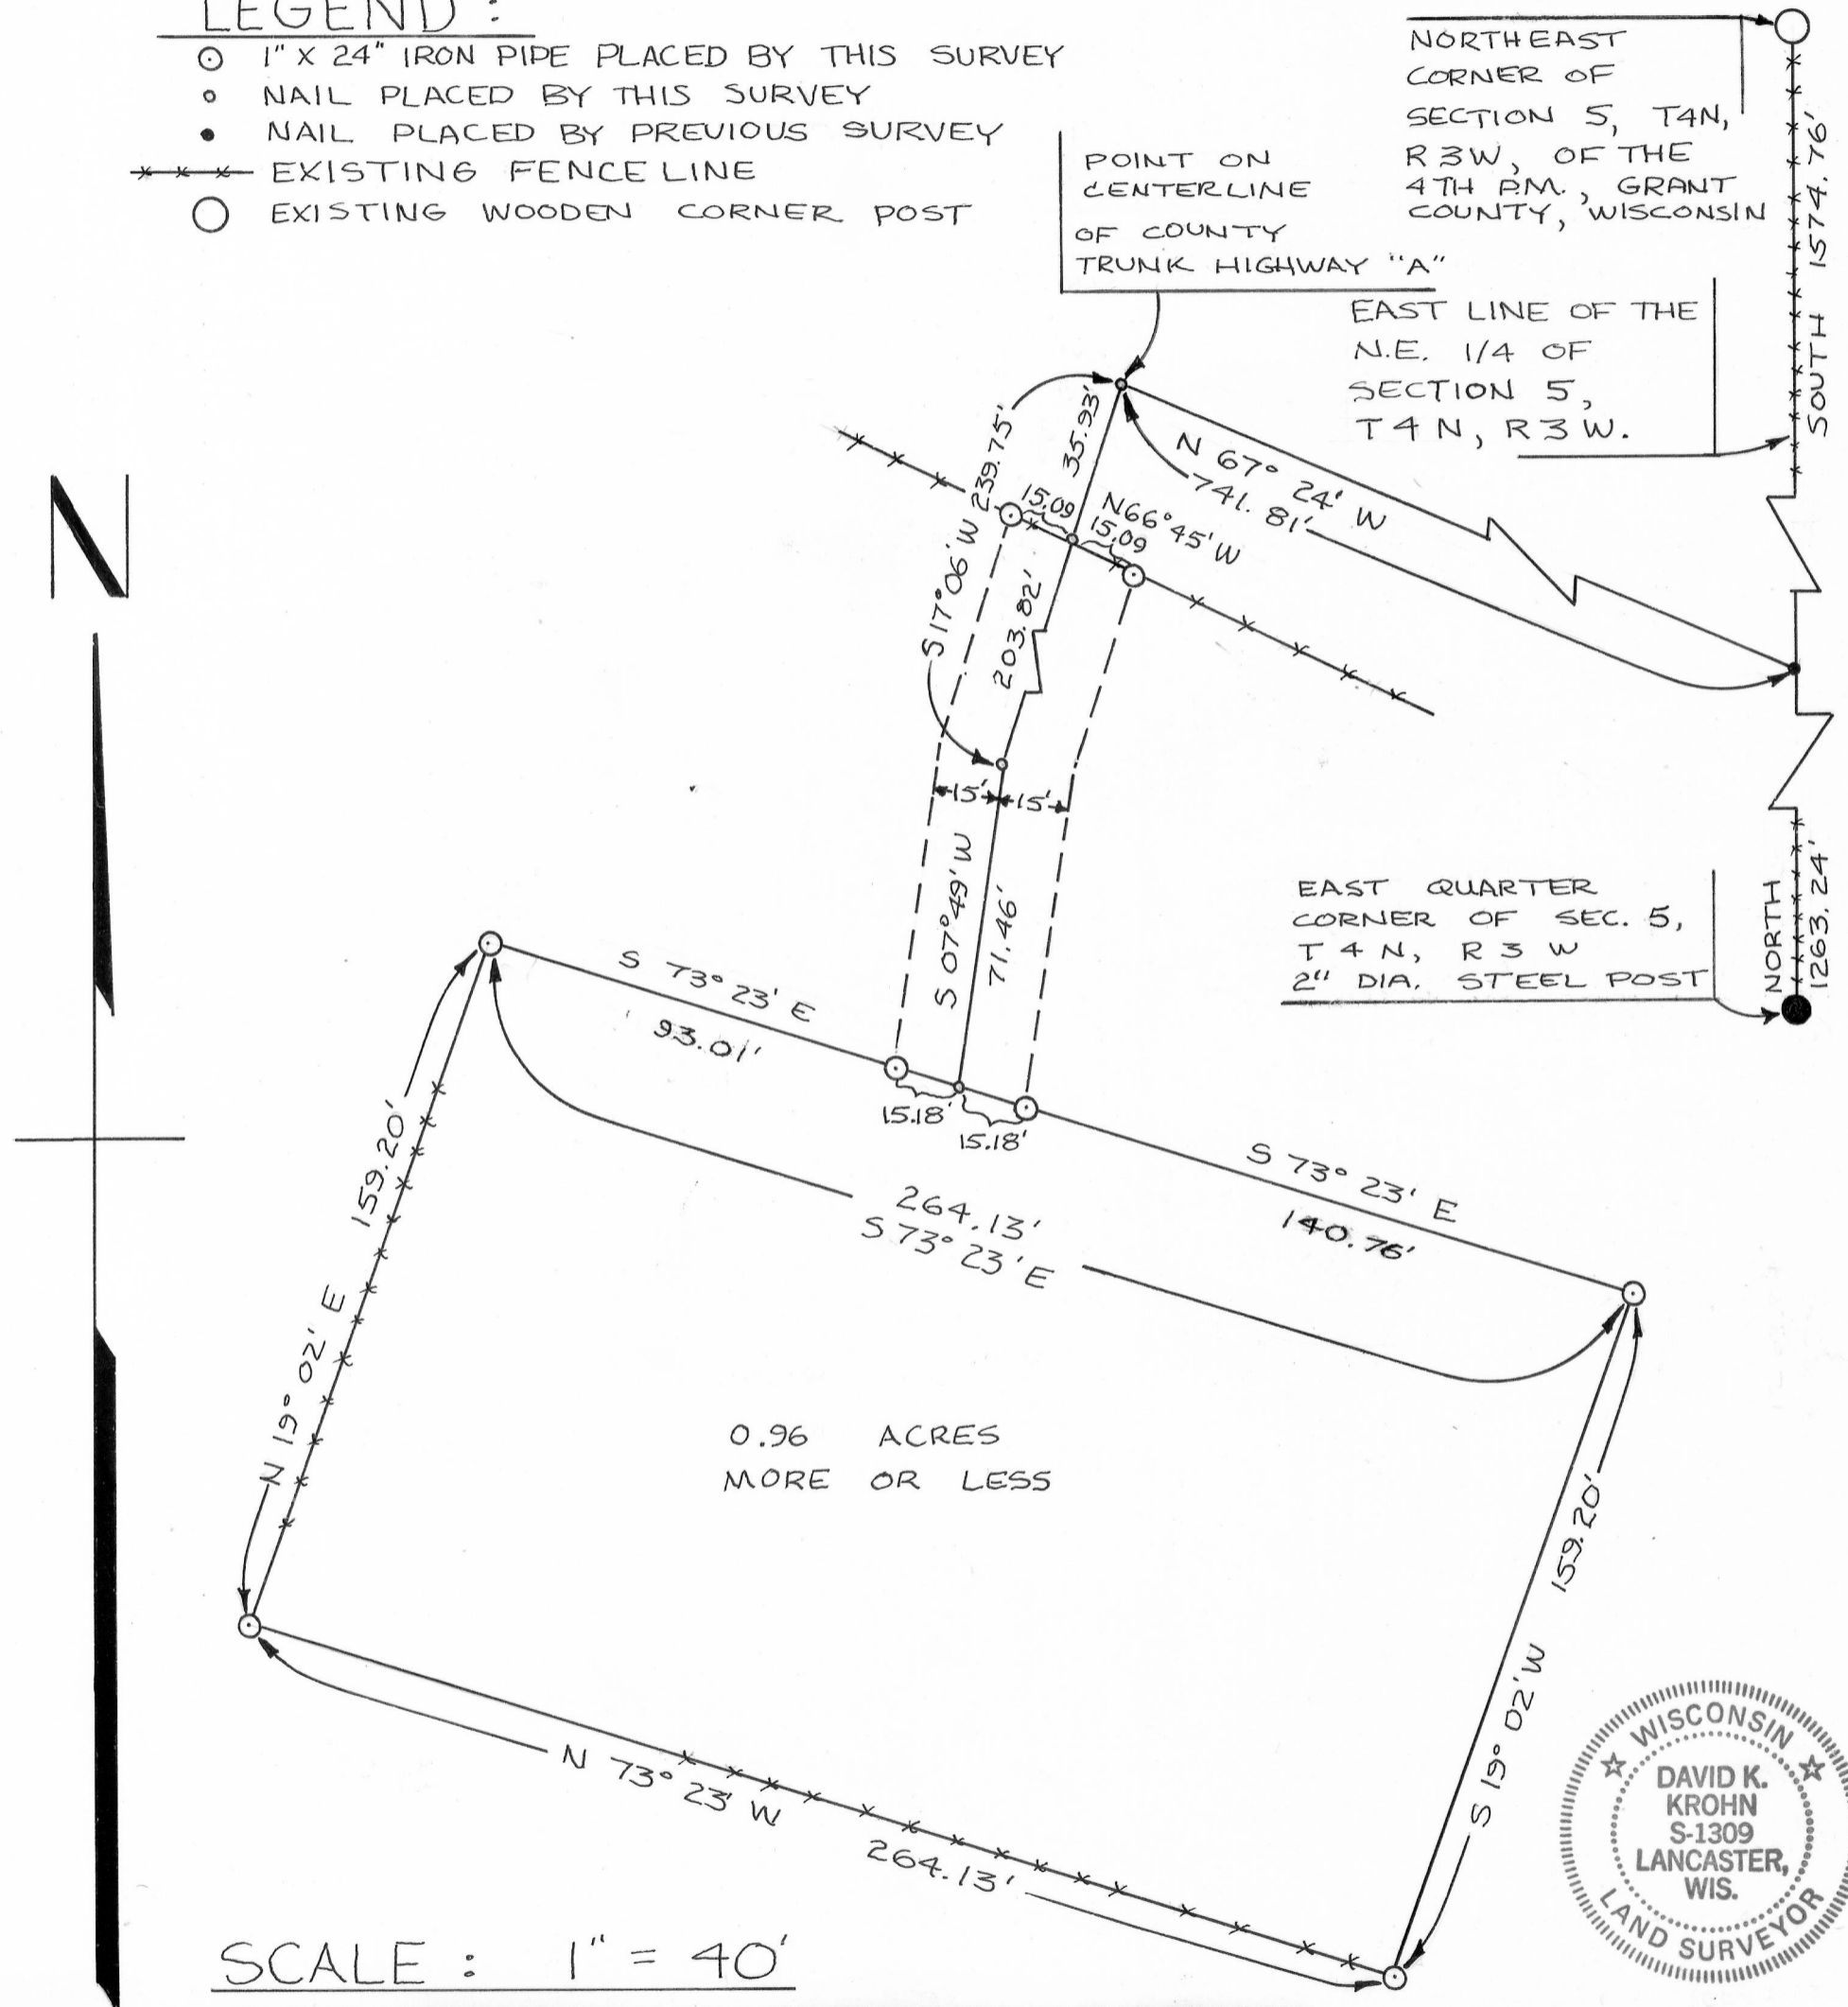

DESCRIPTION:

Part of the E.1/2 of the N.E.1/4 of Section 5, T 4 N, R 3 W, of the 4th P.M., Grant County, Wisconsin, described as follows to-wit:

Commence at the Northeast Corner of said Section 5;

thence South 1574.76 feet;

thence North $67^{\circ} 24'$ West 741.81 feet;

thence South $17^{\circ} 06'$ West 239.75 feet;

thence South $07^{\circ} 49'$ West 71.46 feet to the point of beginning;

thence South $73^{\circ} 23'$ East 155.94 feet to a 1 inch diameter iron pipe;

thence South $19^{\circ} 02'$ West 159.20 feet to a 1 inch diameter iron pipe;

thence North $73^{\circ} 23'$ West 264.13 feet to a 1 inch diameter iron pipe;

thence North $19^{\circ} 02'$ East 159.20 feet to a 1 inch diameter iron pipe;

thence South $73^{\circ} 23'$ East 108.19 feet to the point of beginning.

Containing 0.96 acres more or less.

EASEMENT DESCRIPTION:

Part of the E.1/2 of the N.E.1/4 of Section 5, T 4 N, R 3 W, of the 4th P.M., Grant County, Wisconsin, described as follows to-wit:

Commence at the Northeast Corner of said Section 5;

thence South 1574.76 feet;

thence North $67^{\circ} 24'$ West 741.81 feet to a point on the centerline of County Trunk Highway "A", said point being the point of beginning of a strip of land 30.00 feet in width, lying 15.00 feet on each side of the following described line;

thence South $17^{\circ} 06'$ West 239.75 feet;

thence South $07^{\circ} 49'$ West 71.46 feet, extending or shortening the side lines at the South end of this line so as to terminate at the property line of the land being granted.

I certify that I have surveyed the above described parcel of land and that the attached or accompanying plat is an accurate survey and true representation thereof and correctly shows the exterior boundary lines of said parcel and the correct measurements thereof.



David K. Krohn
 DAVID K. KROHN
 7121177 - 7127177
 REG. NO. 1309

DATED THIS 27TH DAY OF JULY, 1977

