



PLAT OF SURVEY

For: Bill Waterman (Robert Nelson Farm)  
Boscobel, Wis.

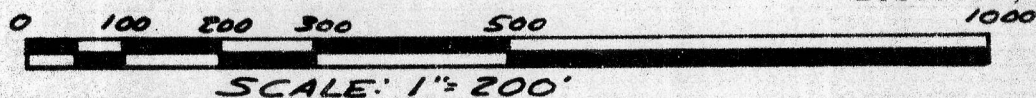

SURVEY JO, V.M  
DATE OF SURVEY:  
JULY '79  
FLD BK. NO. 45

DRAWN: B.J.  
OFFICE NO.  
795076

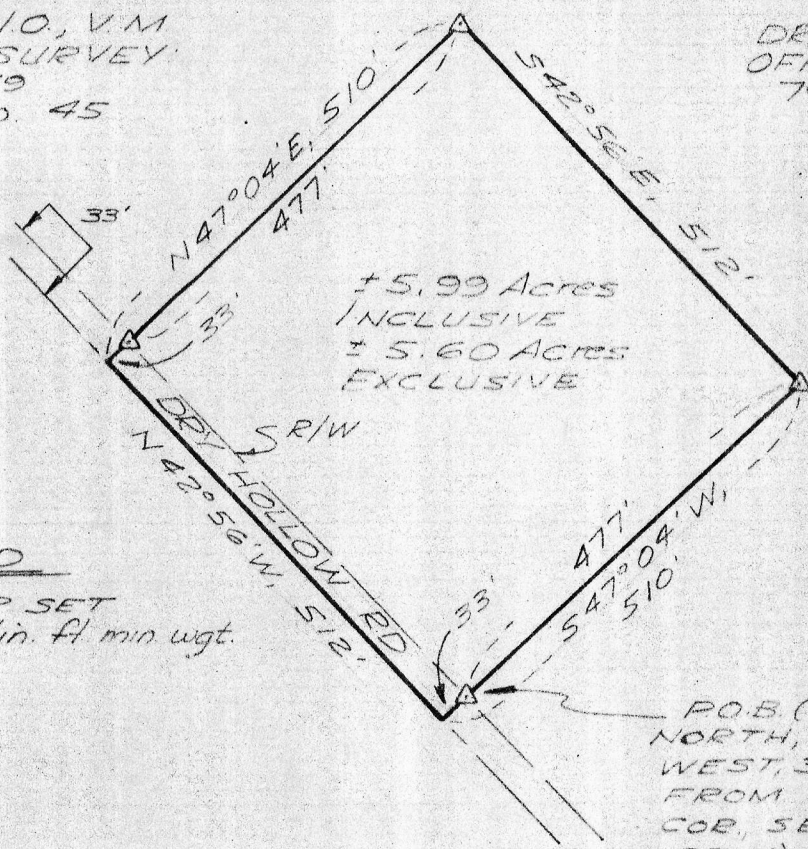

PLAT BEARINGS REFERENCED  
TO THE MAGNETIC NORTH AS  
OF JULY 24, 1979  
ASSUMED BRG-NORTH

LEGEND

△ #6 REBAR SET  
1.50 lb./lin. ft min wgt.

Description

A parcel of land located in the NE $\frac{1}{4}$ , NW $\frac{1}{4}$ , SW $\frac{1}{4}$  and SE $\frac{1}{4}$ , all of the NW $\frac{1}{4}$ , Section 13, T7N, R3W, Town of Marion, Grant County, Wisconsin, described as follows:

Commencing at a #6 re-bar marking the SE corner of said Section; thence North, 3743'; thence West, 3775.68' to a #6 re-bar lying on the NE'ly right-of-way line of Dry Hollow Road, said point being the point of beginning; thence S47°04'W, 33' to the centerline of said Road; thence N42°56'W, 512' along said centerline; thence N47°04'E, 33' to a #6 re-bar lying on said right-of-way line; thence continuing N47°04'E, 477' to a #6 re-bar; thence S42°56'E, 512' to a #6 re-bar; thence S47°04'W, 477' to the point of beginning. Contains 5.99 Acres, more or less.

Said parcel is subject to an easement for town road purposes across the SW'ly 33' thereof and contains 5.60 Acres, more or less, exclusive of said easement.

Said parcel may be subject to other easements of record and/or usage.

SURVEYOR'S CERTIFICATE

I hereby certify that I have made a survey according to the instructions furnished to me and that the plat drawn hereon is a correct representation of that survey to the best of my knowledge and belief.

*David A. Davis Aug. 6, 1979*

David A. Davis, RLS# S-1498  
Southwest Engineering, Inc.  
206 S. Iowa St.  
Dodgeville, Wis., 53533  
Ph. 608-935-2721



COPY