

NORTHWEST CORNER OF SECTION 24, T 8 N, R 3 W. NO MONUMENT

NORTHEAST CORNER OF SEC. 24, T 8 N, R 3 W.

OLD TOWN ROAD RIGHT-OF-WAY

1052.40'
N 88° 40' W
1568.28'
NO FENCE


N 88° 42' W
2620.68'
NO FENCE

1847' TO THE BANK OF THE WISCONSIN RIVER.
NO DOUBLE CORNER IN ORIGINAL NOTES
N 89° 13' W
2594.52'
NO FENCE

SEE SURVEY DONE BY H. D. RALPH, JR. FOR STATE OF WIS. - CONSERVATION DEPARTMENT, DATED 2/27/61.

FOUND LIMESTONE 3" X 14" X 24" AND THE BOTTOM OF A ROTTED POST IN EXISTING BROKEN DOWN NORTH - SOUTH FENCE LINE. RAISED THE STONE, SET VERTICAL AND CHISELED AN "X".

WOODEN FENCE POST INDICATED AS THE SOUTH QUARTER CORNER OF SECTION 18, T 8 N, R 2 W, ON A SURVEY DONE BY RAHA FOR F. ZIMPLE. DATED 1971.

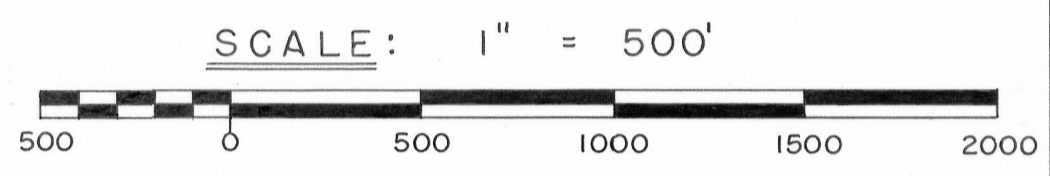


N

LEGEND:

⊙ 1" X 24" IRON PIPE PLACED BY A PREVIOUS SURVEY

David K. Krohn
DAVID K. KROHN
5/27/75 - 10/24/75

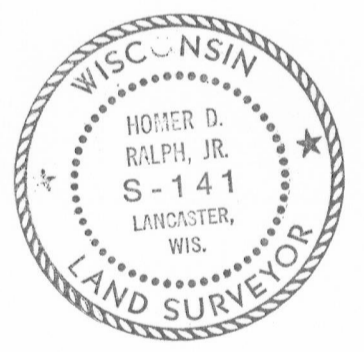

Homer D. Ralph, Jr.
HOMER D. RALPH, JR.
SURVEYOR FOR GRANT COUNTY, WISCONSIN.

5306.21'
N 00° 04' 24" W
ALL BEARINGS REFERENCED TO THE NORTH-SOUTH QUARTER SECTION LINE OF SECTION 24, T 8 N, R 3 W. ASSUMED BEARING OF LINE IS N 00° 04' 24" W AS SHOWN ON A SURVEY BY H. HOVELSRUD FOR JACK RATH, DATED AUGUST 23, 1973.

NO MONUMENT WEST QUARTER CORNER OF SECTION 19, T 8 N, R 2 W, AS ESTABLISHED BY A WILBUR CLARK SURVEY FOR LEON GOULD. DATED APRIL 1975.

(RECORDED AS N 00° 20' 34" W)

N 00° 06' E
2735.78'

(RECORDED AS N 00° 06' W)

SURVEY TO ESTABLISH THE EAST LINE OF THE NE 1/4 OF SECTION 24, T 8 N, R 3 W, OF THE 4TH P.M., GRANT COUNTY, WISCONSIN.

SEE A SURVEY DONE BY H. HOVELSRUD FOR SYL OLSON, DATED AUGUST 9, 1973. DID NOT FIND ANY SURVEY MARKERS ALONG THE EAST LINE OF THE S.E. 1/4 OF SEC. 24 PLACED BY THAT SURVEY.

(RECORDED AS S 88° 14' 41" E)

N 88° 10' W
2613.96'

30" DIA. OAK TREE AS CORNER ORIGINAL NOTES INDICATE A DOUBLE CORNER BUT ONE DOES NOT EXIST IN THE FIELD. SEE DETAIL.

DETAIL	
NO	SCALE
24	19
28.38'	30
25	