

City of Cuba City
 Sec 36, T2N, R1W

82S-006

PLAT OF SURVEY

(Cuba City, Wisconsin, cable television facility)

For: Isselhard & Carroll, Ltd.
 69 W. Washington
 Suite 1616
 Chicago, Ill.


&

Southern Wisconsin Cablevision, Inc.
 105 S. Main St.
 Cuba City, Wisconsin



See AGREEMENT recorded in Vol. 555, page 586, Grant County Registry regarding concrete block building.

NOTE: Bearings referenced to the East line of Block 7 of the Original Plat of Cuba City as re-established in a survey by David K. Krohn for Cuba City State Bank.
 Assumed bearing - North.

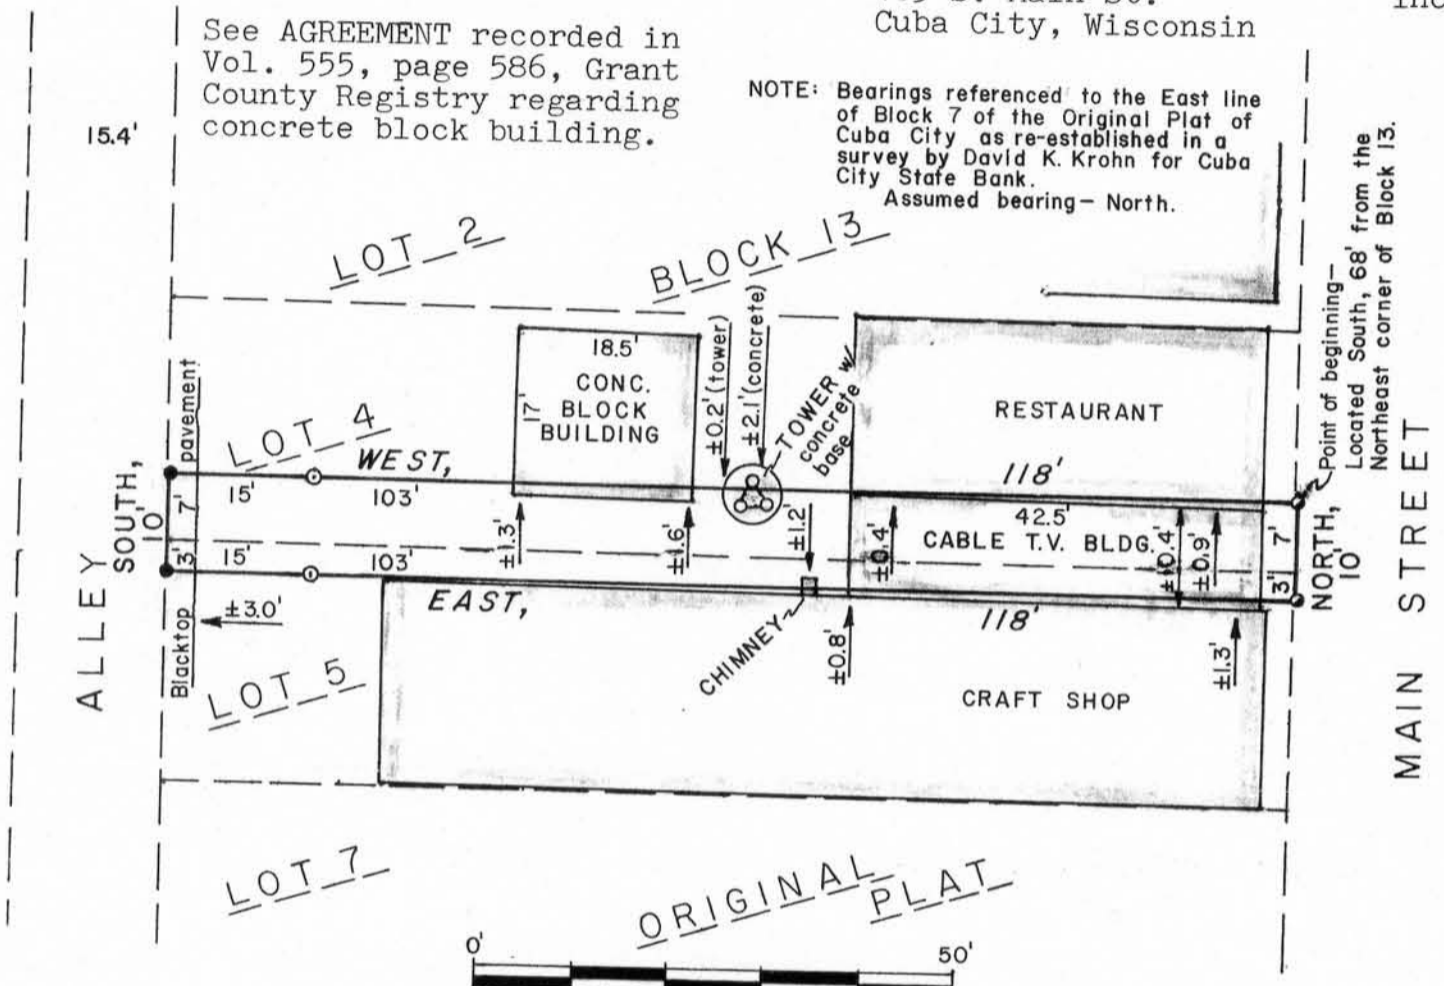

- — 1"x24" iron pipe set.
- — P-K nail set.
- ◉ — Drill hole in conc. walk.

Office No. 82S-006
 Field Book No. 1
 Date of survey - Mar. 1982
 Drawn by - D.A.D.

Parcel description

The South 7' of Lot 4 and the North 3' of Lot 5, Block 13 of the Original Plat of the Village (now City) of Cuba City, Grant County, Wisconsin.

Surveyor's Certificate

I have surveyed the above described property and the above map is a true representation thereof and shows the size and location of the property, its exterior boundaries, the location and dimensions of all visible structures thereon, fences, apparent easements and roadways and visible encroachments, if any.

This survey is made for the exclusive use of the present owners of the property, and those who purchase, mortgage, or guarantee the title thereto within one (1) year from date hereof.

David A. Davis March 23, 1982

David A. Davis, RLS# S-1498 Revised March 25, 1982
 206 S. Iowa St.
 Dodgeville, Wis., 53533
 Ph. (608)935-2721



MAR 26 1982